

Ellsworth

Form 51-5M-5-34-Palace


Map No. **KANSAS** Sec. 7 Twp. 17 R. 10^W

Well No. 3 *Andrea* Farm
Magnolia Company

NORTH

WEST

EAST

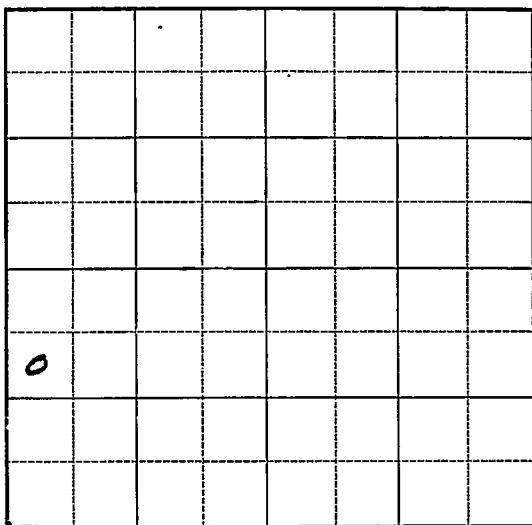

SOUTH

Location _____

Drilling Remarks _____

Rig Up _____

Drilling Remarks _____

RECORD

Cased _____ in. _____ ft.

Sand _____

Gas _____

Oil _____

Total Depth _____

PRODUCTION

1st 24 hrs. Nat. _____

1st 24 hrs. after shot _____

Gas _____ cu. ft.

Dry Hole _____

Abandoned _____

KANSAS

Ellsworth

Map No. _____ Sec. 7 Twp. 17 R. 10W

Well No. 3 Andrea Farm


Magnolia Company

990 Ft. from N. Line

_____ Ft. from S. Line

_____ Ft. from E. Line

330 Ft. from W. Line

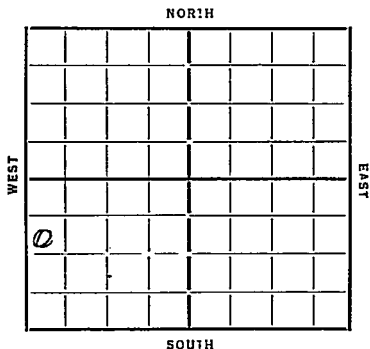

Date

REPORT

8/15	Location
8/23	Material
8/30	Rign
9/6	_____
9/13	415 Run 15"
9/20	Dly 835 13" 690
9/27	" 1840
10/4	1970 feg bilin
10/11	A. Sec 2000-05 10" 1940
	Dly 2265
10/18	Dly 2660 8" 2415
10/25	6" 3030 Lansing 3027
	A. A. 3052-54
11/1	A.P.O. 3132-35 Pay 3192-98 T1)
	Pump 8 oil 27 water 9 hrs.
11/8	1000 acid P 60 & 40 W
11/15	_____ 11/22 _____
11/28	Set 6" 3170
12/6	Acidize
12/12	Lansing 3027 Oil 3192-98
	T1 3198 1000 acid
	98 Blk.

COMPLETED

Edenworth

WASAS

Map No. 55 Sec. 7 Twp. 17 R. 10^W

Well No. 3-Andrea

Magnolia Company

Contractor

FIRST REPORTS

SECTION PLAT

990 Ft. from N. Line

Ft. from S. Line

Ft. from E. Line

330 Ft. from W. Line

0			

Location ✓

Rig up

Drilling and Remarks:

RECORD

Cased in., ft.

Sand

Gas

Oil

Total Depth

PRODUCTION

1st 24 hrs. Nat.

1st 24 hrs. after shot

Gas Cu. Ft.

Dry Hole

Abandoned

Date

875-34 19

ORVAL MANNSCHRECK

Scout

Map No. 55 Sec. 7 Twp. 17 R. 10WWell No. 3- AndreaMagnolia Petroleum Company

Contractor

COMPLETED

SECTION PLAT

990 Ft. from N. Line

Ft. from S. Line

Ft. from E. Line

530 Ft. from W. Line

0			

Location

Rig up

Drilling and Remarks:

1000 acid98 bbls

RECORD

Cased in., ft.

Sand Lansing 3027

Gas

Oil 3192-98Total Depth 3198

PRODUCTION

1st 24 hrs. Nat.

1st 24 hrs. after shot

Gas Cu. Ft.

Dry Hole

Abandoned

Date

ORVAL MANNSCHRECK

12-12-34 192 Scout