



Map No. KANSAS Sec. 7 Twp. 17 R. 10<sup>w</sup>


Well No. 2 Breford Farm  
Slick, P. & Lockhart Company

\_\_\_\_\_ Ft. from N. Line

330 Ft. from S. Line

\_\_\_\_\_ Ft. from E. Line

990 Ft. from W. Line

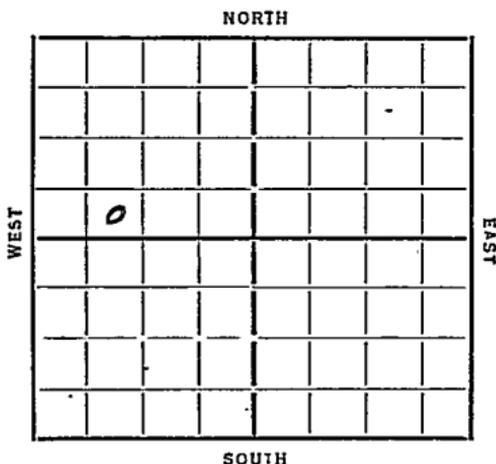

Date	REPORT
9/19	Spud
9/27	20" 190 15" 401 Dly 455
10/4	Dly 1360 13" 686.
10/11	" 2265 A Gas 1565 10" 1910
10/18	8" 2438 Log 2617
10/25	2860 W R 8"
11/1	Lansing 3030 T 1) 3034 Cen 6" P B P
11/8	A.O. 3130 W. 3135-40.
11/15	A.O. 3232-37 Cong 3335 5" 3352 C.O.
11/22	Silicious 3352 T 1) 3383 Est 300 Bbls oil per day
11/27	Silicious 3352 T 1) 3383 300 Bbls.
COMPLETED	

Form 26-1M Bks. 7-2-20  
Edsforth

KANSAS

Map No. 55 Sec. 7 Twp. 17 R. 10W

Well No. 2-Brieford

Contractor

SECTION PLAT

	0		

       Ft. from N. Line  
330 Ft. from S. Line  
       Ft. from E. Line  
990 Ft. from W. Line

FIRST REPORTS

Location \_\_\_\_\_

Rig up \_\_\_\_\_

Drilling and Remarks:

*Mud*

RECORD

Cased \_\_\_\_\_ in., \_\_\_\_\_ ft.  
Sand \_\_\_\_\_  
Gas \_\_\_\_\_  
Oil \_\_\_\_\_  
Total Depth \_\_\_\_\_

PRODUCTION

1st 24 hrs. Nat. \_\_\_\_\_  
1st 24 hrs. after shot \_\_\_\_\_  
Gas \_\_\_\_\_ Cu. Ft.  
Dry Hole \_\_\_\_\_  
Abandoned \_\_\_\_\_

Date

9-19-37 19\_\_\_\_

ORVAL MANNSCHRECK  
Scout

KANSAS

Form 26-1M Bks. 9-28

*Edworth*

Map No. 55 Sec. 7 Twp. 17 R. 10W

Well No. 2-Breford

Slick pt Company

Contractor

COMPLETED

SECTION PLAT

0			

.....Ft. from N. Line

330 Ft. from S. Line

.....Ft. from E. Line

990 Ft. from W. Line

RECORD

Location.....

Cased.....in. ....ft.

Rig up.....

Sand silicious 3352

Drilling and Remarks:

Gas.....

Oil.....

Total Depth 3383

300 bbl

PRODUCTION

1st 24 hrs. Nat.....

1st 24 hrs. after shot.....

Gas.....Cu. Ft.

Dry Hole.....

Abandoned.....

Date

11-27-37 192

ORVAL MANNSCHRECK

Scout