


KANSAS**Ellsworth**Section 7 Township 17 Range 10WWell No. 1 BrefordCompany N C R A**Bloomer**

NORTH

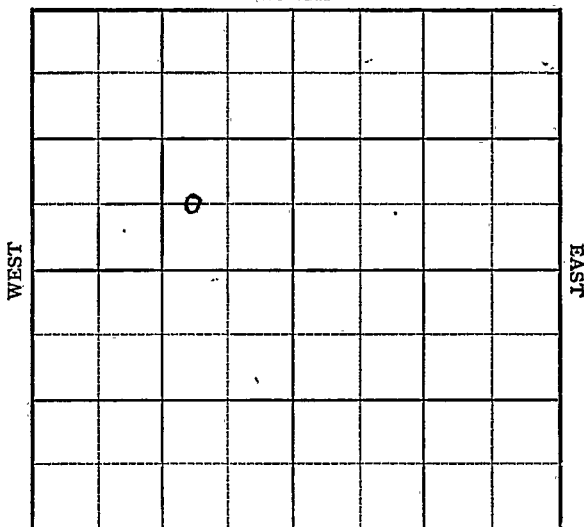

SOUTH

Ellsworth **KANSAS** ✓

Sec. 7 Twp. 17 R. 10W

Well No. #1 Breford Farm

N C R A

Company

Bloomer Pool


 Ft. from N. Line

660' Ft. from S. Line

990' Ft. from E. Line

 Ft. from W. Line

C W L SE NW

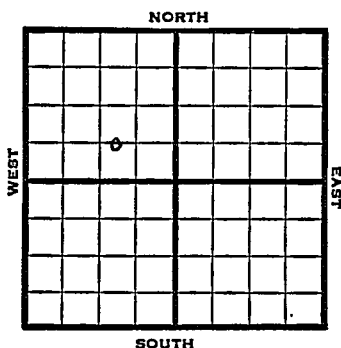

1949 Elev 1911' REPORT

5/25 Lans. 3037'

Dr1g. 3284'

6/1 Weathered Arb. 3368-81'

TD 3371'

5"@ 3371'

6/7 "

6/15 W Arb 3368'

TD 3393'

Aband.

ABANDONED

Map No. _____ Sec. 7 Twp. 17 R. 10W

Well No. 1 Breford

N C R A

Company _____

Contractor _____

C W L SE NW


**FIRST REPORT
SECTION PLAT**

_____ Ft. from N. Line

660 Ft. from S. Line

990 Ft. from E. Line

_____ Ft. from W. Line

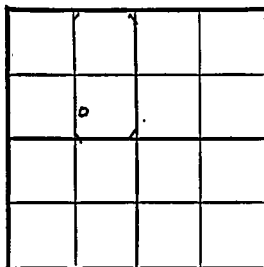

Ellsworth County

Location _____

Rig up _____

Drilling and Remarks:

Lans. 3037

drlg. 3284

RECORD

Cased _____ in., _____ ft.

Sand _____

Gas _____

Oil _____

Total Depth _____

PRODUCTION

1st 24 hrs. Nat. _____

1st 24 hrs. after shot _____

Gas _____ Cu. Ft.

Dry Hole _____

Abandoned _____

Date

MAY 25 1949

19

S. J. LEWIS

Scout

Ellsworth County Kansas State

Map No. K55 Sec. 7 Twp. - 17 R. 10W

Well No. 1 Breford

N C R A Company

ABANDONED Contractor
C WL SE NW

E11911
SECTION PLAT

 Ft. from N. Line

660 Ft. from S. Line

990 Ft. from E. Line

 Ft. from W. Line

Bloomer Pool

Remarks:

W. Cu 42368

J. D 3373

Date

Scout

JUN 15 1949