


Section 7 Township 17 Range           

Well No. #1 Frevert

Company Todd Drlg. et al

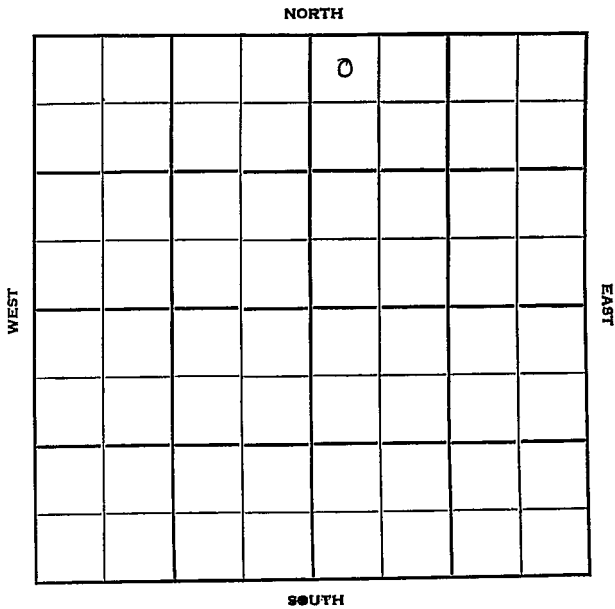

Sec. 7 Twp. 17 R. 10W

Well No. #1 Frevert Farm

Todd Drlg. et al Company

Todd Drlg.- Contr. Contractor


330' Ft. from N. Line

\_\_\_\_\_ Ft. from S. Line

\_\_\_\_\_ Ft. from E. Line

330' Ft. from W. Line

NW NW NE

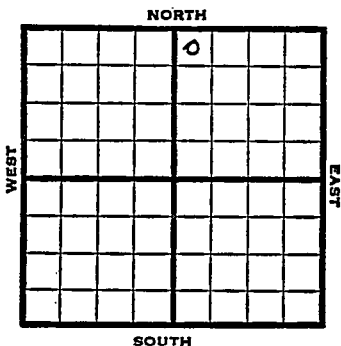

1950

Elev. 1910' **REPORT**

12/13

Location

1951

1/24

Spud 12-15-50  
 D&A TD 3376  
 8" @ 225' Anhy 685-710  
 Heeb. 2932' Br Lime 3036  
 Lans. 3052' Cong. 3347  
 Arb. 3352-60 5" @ 3352  
 TD 3367' SSO 500 A  
 DD 3375 1 boph DD 3376  
 SP 3368 4" @ 3362 CO to 3376  
 1 boph 1000 A B/4 go 20 gwph  
 D&A

**ABANDONED**

County Ellsworth State Kansas

Sec. 7 (Blk. Twp.) 17 (Sur. Rge.) 10W Map No.

Operator Todd Drlg. etal.

Well No. 1 Farm F revert

Elev. \_\_\_\_\_ Location NW NW NE


330 Ft. From N Line NE

330 Ft. From W Line Quarter

1st. Report DEC 1 3 1950

Completion \_\_\_\_\_

Remarks \_\_\_\_\_

Todd Drlg. - Contr.

Spudding Date \_\_\_\_\_

Drlg. Data \_\_\_\_\_

Location

