



Ellsworth

Map No. KANSAS Sec. 7 Twp. 17 R. 10<sup>W</sup>


Well No. 4 Andrea Farm  
Magnolia Pt. Company

330 Ft. from N. Line

\_\_\_\_\_ Ft. from S. Line

\_\_\_\_\_ Ft. from E. Line

1115 Ft. from W. Line

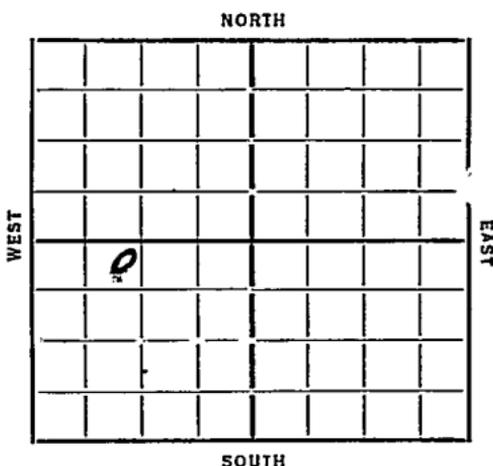

Twire Well.

Date	REPORT
<u>1955</u>	
<u>1/30</u>	<u>Location</u>
<u>2/6</u>	<u>_____</u>
<u>2/14</u>	<u>Sign</u>
<u>2/21</u>	<u>_____</u>
<u>2/28</u>	<u>Dlg 175</u>
<u>3/7</u>	<u>" 540</u>
<u>3/14</u>	<u>16" 430 13" 705 Dlg 1300</u>
<u>3/21</u>	<u>1975 pay</u>
<u>3/28</u>	<u>Dlg 2308</u>
<u>4/4</u>	<u>" 2845</u>
<u>4/11</u>	<u>8" 3057 KC 3119 50 3119-32</u> <u>HFV 3180-90 6" 3282</u>
<u>4/18</u>	<u>Cong 3341 Sil 3368 WR6"</u>
<u>4/26</u>	<u>6" 3368</u>
<u>5/2</u>	<u>Pay 3379-83 50' oil 3400 sud</u> <u>PA 3384 1000 acid</u>
<u>5/8</u>	<u>Silicious 3368 T 17 3383</u> <u>S.O. 3379-83</u> <u>1000 acid</u>
	<u>7 &amp; A.</u>
	<b>ABANDONED</b>

Map No. 55 Sec. 7 Twp. 17 R. 10W

Well No. 4 - Andrea

Magnolia pet Company

Contractor

**FIRST REPORTS**


**SECTION PLAT**

330 Ft. from N. Line

..... Ft. from S. Line

..... Ft. from E. Line

1115 Ft. from W. Line

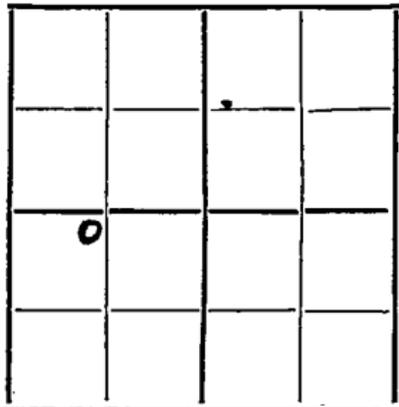

Twin well

Location ✓

Rig up .....

Drilling and Remarks:

**RECORD**

Cased.....in., .....ft.

Sand.....

Gas.....

Oil.....

Total Depth.....

**PRODUCTION**

1st 24 hrs. Nat.....

1st 24 hrs. after shot.....

Gas..... Cu. Ft.

Dry Hole.....

Abandoned.....

Date

**ORVAL MANNSCHRECK**  
Scout

1-30-35 192.....

*Eldersmith*

Map No. 55 Sec. 7 Twp. 17 R. 10W

Well No. 4 - Andrea

Magnolia pet. Company

Contractor

**ABANDONED**

SECTION PLAT

330 Ft. from N. Line

..... Ft. from S. Line

..... Ft. from E. Line

1115 Ft. from W. Line

0			

Location.....

Rig up.....

Drilling and Remarks:

*A. O. 3379-83  
1000 acid*

*OV FF*

**RECORD**

Cased..... in., ..... ft.

Sand Silicous 3368

Gas.....

Oil.....

Total Depth 3383

**PRODUCTION**

1st 24 hrs. Nat.....

1st 24 hrs. after shot.....

Gas..... Cu. Ft.

Dry Hole.....

Abandoned.....

Date

5-8-35 192

**ORVAL MANNSCHRECK**

Scout