KANSAS


FORM 51 5M 10-41 PETROL

McPherson

Section 7 Township 17 Range 3-W

Well No. ½ 2 Johnson

Company Bay Petroleum

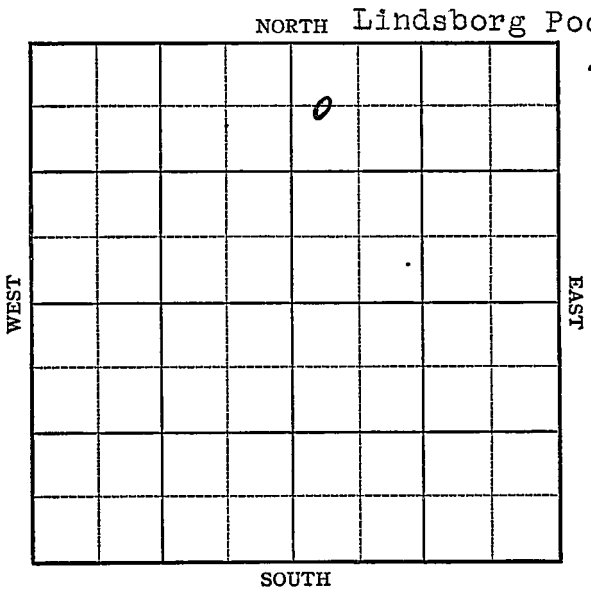

Form 252-A
5M 5-42 Petrol

KANSAS McPherson

Sec. 7 Twp. 17 R. 3-W

Well No. #2 Johnson Farm

Bay Petr. Company


(Lindsborg)

660 Ft. from N. Line

Ft. from S. Line

Ft. from E. Line

330 Ft. from W. Line

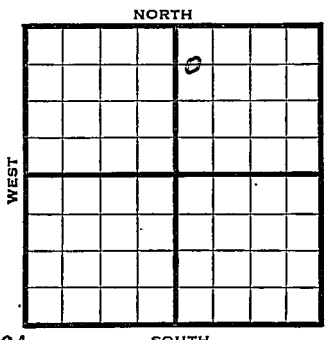

Elev. 1364

1942	REPORT
7/8	Cellar.
7/15	"
7/22	8" @ 342 WOC
7/29	" "
8/5	" "
8/12	" "
8/19	Drlg. 2505'
8/27	Drlg 2905
9/2	Viola 3373-77 T.D. 5" - 3374 RUST.
9/9	" " "
9/16	5000 acid
9/23	2000 acid testing.
9/30	TD 3377 Tstg.
10/7	" "
10/14	" "
10/21	Viola 3373 5" @ 3374 T.D. 3377 2500 Acid Pump 347 Pot. Gravity 36 COMPLETED

Form 26 200 Bks. 5-41 McW.

KANSAS

McPherson

Map No. 42 Sec. 7 Twp. 17 R. 3W

Well No. 2 Johnson

Bay Petroleum Company

FIRST REPORT Contractor

C WL NW NE


660 Ft. from N. Line

____ Ft. from S. Line

____ Ft. from E. Line

330 Ft. from W. Line

SECTION PLAT

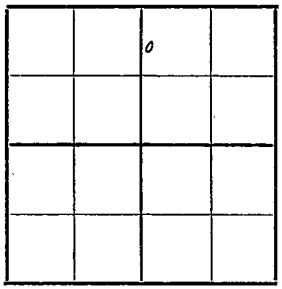

LINDSBORG POOL

Location

Rig up

Drilling and Remarks:

Cellar

RECORD

Cased ____ in., ____ ft.

Sand

Gas

Oil

Total Depth

PRODUCTION

1st 24 hrs. Nat.

1st 24 hrs. after shot

Gas ____ Cu. Ft.

Dry Hole

Abandoned

Date

JUL 8 1942 19

S. J. LEWIS Scout

Form 26 200 Bks 5-42 Petrol

McPherson KANSAS

Map No. 47 Sec. 7 Twp. 17 R. 3W

Well No. 2 Johnson

Bay Petroleum Company

COMPLETED Contractor

C WL NW NE


660 Ft. from N. Line

____ Ft. from S. Line

____ Ft. from E. Line

330 Ft. from W. Line

SECTION PLAT

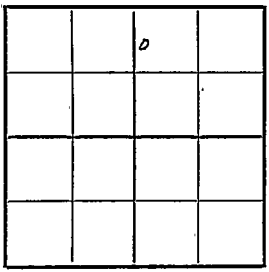

LINDSBORG POOL

Location

Rig up

Drilling and Remarks:

Viola 3373

5" @ 3374

2500 acid

Pump 347 Bbl.

36° Gr

RECORD

Cased ____ in., ____ ft.

Sand

Gas

Oil

Total Depth 3377

PRODUCTION

1st 24 hrs. Nat.

1st 24 hrs. after shot

Gas ____ Cu. Ft.

Dry Hole

Abandoned

Date

OCT 21 1942 19

S. T. LEWIS Scout