

McPherson

FORM 51 5M 4-41 PETROL.

Section 7 Township 17 Range 3-W

Well No. #1 Johnston

Company. M. & L. Oil

NORTH Wildcat

15

WEST

EAST

0

SOUTH


Sec. 7 Twp. 17 R. 3-WWell No. #1 Johnston FarmM & L Oil

Company

(Wildcat)

 Ft. from N. Line660 Ft. from S. Line Ft. from E. Line330 Ft. from W. Line

Elev. 1344

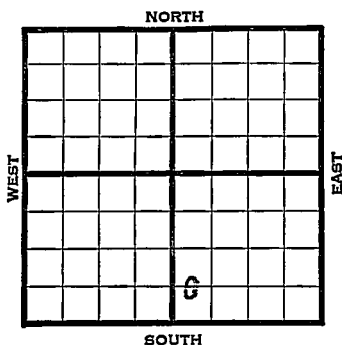

1941	REPORT
10/1	10" - 254'
	WOC.
10/9	Drlg. 650'
10/16	Drlg. 1950'
10/23	Lans. 2238' Drlg. 2825'
10/30	Miss. 2908' Drlg. 3200'
11/6	Viola 3347' 5" - 3347½'
	T.D. 3348½' RUST.
11/13	T.D. 3353' 2850' oil 4½ hours.
11/20	" " " " "
11/26	" " " " "
12/4	T.D. 3354' 840 acid.
	Estimate 25 oil per hour.
12/10	Viola 3347'
	5" - 3347½'
	T.D. 3354'
	3000 acid.
	Potential 759 bbls., pump.
	40. Gravity
	COMPLETED

Map No. K-42 Sec. 7 Twp. 17 R. 3WWell No. 1 JohnstonM & L Oil CompanyContractor**FIRST REPORT**

C WL SW SE

 Ft. from N. Line660 Ft. from S. Line Ft. from E. Line330 Ft. from W. Line

WILDCAT

SECTION PLAT

		0	

RECORDLocation Cased in., ft.Rig up Sand

Drilling and Remarks:

Gas

10" - 254

Oil Waiting on
Cement to SetTotal Depth **PRODUCTION**1st 24 hrs. Nat. 1st 24 hrs. after shot Gas Cu. Ft.Dry Hole Abandoned

Date

OCT 1 1941 19S. J. LEWIS Scout

McPherson

KANSAS

Map No. 42 Sec. 7 Twp. 17 R. 3WWell No. 1 JohnstonM & L Oil CompanyCOMPLETED Contractor

C WL SW SE

 Ft. from N. Line660 Ft. from S. Line Ft. from E. Line330 Ft. from W. Line

SECTION PLAT

WILDCAT

Location Rig up

Drilling and Remarks:

*Vid 3347**5" @ 3347 1/2**3000 acid**Pump 759 Pst**40° Gr*

RECORD

Cased in., ft.Sand Gas Oil Total Depth 3354

PRODUCTION

1st 24 hrs. Nat. 1st 24 hrs. after shot Gas Cu. Ft.Dry Hole Abandoned

Date

DEC 10 1941

19

S. J. LEWIS

Scout