

KANSAS

FORM 51 5M 10-41 PETROL


McPherson

Section 7 Township 17 Range 3-W

Well No. #2 Nelson

Company M & L Oil

NORTH Lindsborg Pool

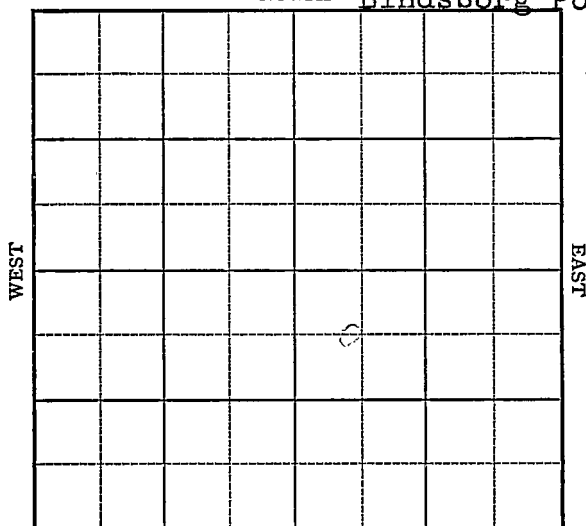

SOUTH

Sec. 7 Twp. 17 R. 3-W

Well No. #2 Nelson Farm

M & L Oil Company

(Lindsborg)


660 Ft. from N. Line

 Ft. from S. Line

 Ft. from E. Line

510 Ft. from W. Line

elev. 1350

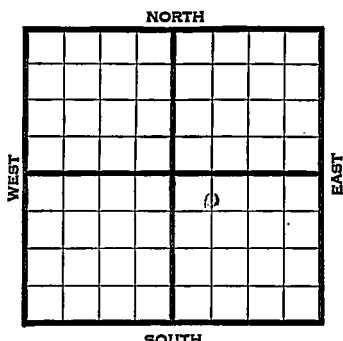

1942	REPORT
3/11	10" - 150' WOC.
3/19	Drlg. 900'
3/26	B.K.C. 2385' Miss. 2930'
	B. Miss. 3105' Drlg. 3230'
4/2	Viola 3360 $\frac{1}{2}$ ' 5" - 3361 $\frac{1}{2}$ ' Drlg. 3365'
	800' oil 12 hours.
4/8	T.D. 3371' 3000 acid. Swab 47 oil.
4/15	" " " "
4/22	" " " "
4/29	" " " "
5/6	" " " "
5/13	Viola 3360 $\frac{1}{2}$ '
	5" - 3361 $\frac{1}{2}$ '
	T.D. 3371'
	3000 acid.
	Potential 518 bbls., pump.
	36. Gravity
	COMPLETED

KANSAS

McPherson

Map No. 42 Sec. 7 Twp. 17 R. 3WWell No. 2 NelsonM & L Oil Company**FIRST REPORT** Contractor

C NW SE

660 Ft. from N. Line Ft. from S. Line Ft. from E. Line510 Ft. from W. Line**SECTION PLAT**

		o	

LINDSBORG POOLLocation Rig up

Drilling and Remarks:

10" - 150'

Waiting on
cement to set

Carter sold

#1 Well *to M. & L. O.***RECORD**Cased in., ft.Sand Gas Oil Total Depth **PRODUCTION**1st 24 hrs. Nat. 1st 24 hrs. after shot Gas Cu. Ft.Dry Hole Abandoned Date

MAR 1 1 1942

19

S. J. LEWIS

Scout

McPhe rs on , **KANSAS**Map No. 42 Sec. 7 Twp. 17 R. 3WWell No. 2 NelsonM. & L. Oil

Company

COMPLETED

Contractor

C NW SE

SECTION PLAT

660 Ft. from N. Line

Ft. from S. Line

Ft. from E. Line

510 Ft. from W. Line

		o	

LINDSBORG POOL

Location

Rig up

Drilling and Remarks:

Vista 8360 1/2
5" @ 8361 1/2
3000 acid
Pump 518 Rx
362 Gr

RECORD

Cased _____ in., _____ ft.

Sand _____

Gas _____

Oil _____

Total Depth 3321

PRODUCTION

1st 24 hrs. Nat. _____

1st 24 hrs. after shot _____

Gas _____ Cu. Ft.

Dry Hole _____

Abandoned _____

Date

MAY 13 1942

19

S. J. LEWIS Scout