


WELL PLUGGING RECORD

Information Completely
Required Affidavit
or Deliver Report to:
Conservation Division
State Corporation Commission
212 No. Market
Wichita, Kansas 67202

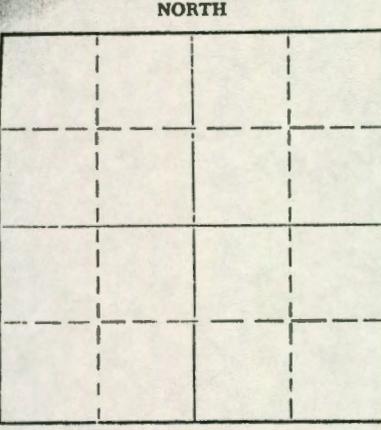

Elsworth County, Sec. 4 Twp. 17 Rge. 8 (E) (W) X
 Location as "NE/CNW%SW%" or footage from lines. NW NE SE
 Lease Owner Leben Oil Co.
 Lease Name Andrews Well No. 1
 Office Address Box 486 Great Bend, Kansas 67530
 Character of Well (completed as Oil, Gas or Dry Hole) _____
 Date well completed _____ 19____
 Application for plugging filed _____ 19____
 Application for plugging approved _____ 19____
 Plugging commenced 8-7-71 _____ 19____
 Plugging completed 8-11-71 _____ 19____
 Reason for abandonment of well or producing formation Depleted
 If a producing well is abandoned, date of last production _____ 19____
 Was permission obtained from the Conservation Division or its agents before plugging was commenced? Yes

Locate well correctly on above Section Plat

Name of Conservation Agent who supervised plugging of this well Gilbert Toman
 Producing formation _____ Depth to top _____ Bottom _____ Total Depth of Well 3376 Feet
 Show depth and thickness of all water, oil and gas formations.

OIL, GAS OR WATER RECORDS

CASING RECORD

FORMATION	CONTENT	FROM	TO	SIZE	PUT IN	PULLED OUT
				8 5/8"	290	None
				5 1/2"	3375	2417.05'

Describe in detail the manner in which the well was plugged, indicating where the mud fluid was placed and the method or methods used in introducing it into the hole. If cement or other plugs were used, state the character of same and depth placed, from _____ feet to _____ feet for each plug set.

Dig cellar. Plugged off bottom with sand to 3275 ft. and dumped 5 sacks cement
 Rig up Jacks. Shot pipe at 2648', 2515 and 2405 ft. Pulled a total of 78 jts.
 of 5 1/2" casing. Placed a 10 ft. rock bridge at 250 ft. and dumped 25 sacks
 cement. Dumped mud to 40 ft., 10 ft. rock bridge and 10 sacks cement to surface.

RECEIVED
STATE CORPORATION COMMISSION
AUG 27 1971
CONSERVATION DIVISION
Wichita, Kansas

(If additional description is necessary, use BACK of this sheet)
 Name of Plugging Contractor Rockhold Engineering, Inc.
 Address P. O. Box 698 Great Bend, Kansas 67530

STATE OF Kansas, COUNTY OF Barton, ss.
James W. Rockhold (employee of owner) or (owner or operator) of the above-described

well, being first duly sworn on oath, says: That I have knowledge of the facts, statements, and matters herein contained and the log of the above-described well as filed and that the same are true and correct. So help me God.

(Signature) James W. Rockhold
P. O. Box 698 Great Bend, Kansas 67530
 (Address)

Subscribed and sworn to before me this 26th day of August, 19 71



Elaine Mauck
 Notary Public.