

Section 8 Township 17 Range 10WWell No. #1 FrohreichCompany Nadel & Gussman

NORTH

						0.	

WEST

EAST

SOUTH

Ellsworth KANSAS

Sec. 8 Twp. 17 R. 10W

Well No. #1 Frohreich Farm

Nadel & Gussman Company

Nadel & Gussman Contractor

Wildcat


330' Ft. from N. Line

 Ft. from S. Line

990' Ft. from E. Line

 Ft. from W. Line

NW NE SE

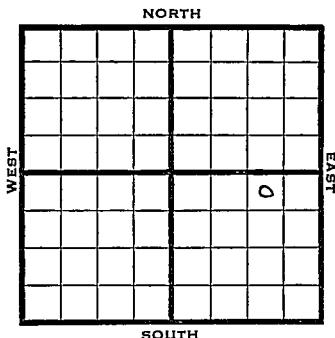

1950 Elev 1864' REPORT

2/15 Spud 2-8-50
8-5/8" @ 300'
Drlg. 2845'
2/22 TD 3391'
8 5/8" @ 300'
Heeb 2888'
Dodge 2911'
Br L 2999'
Lans 3021'
Cong 3313'
Arb. 3346'
D&A
Aband.

ABANDONED

Kansas

Map No. _____ Sec. 8 Twp. 17 R. 10WWell No. 1 FrohreichNadel & Gussman

Company

Nadel & Gussman

Contractor

NW NE SE

El. 1864

SECTION PLAT


330 Ft. from N. Line

_____ Ft. from S. Line

990 Ft. from E. Line

_____ Ft. from W. Line

Ellsworth County

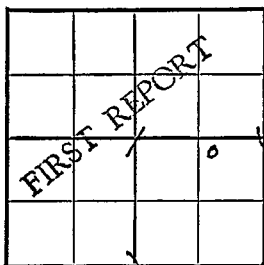

Location _____

Rig up _____

Drilling and Remarks:

Spud 2-8-50

8 5/8" @ 300

drlg. 2845

RECORD

Cased _____ in., _____ ft.

Sand _____

Gas _____

Oil _____

Total Depth _____

PRODUCTION

1st 24 hrs. Nat. _____

1st 24 hrs. after shot _____

Gas _____ Cu. Ft.

Dry Hole _____

Abandoned _____

Date

FEB 15 1950

19

J. E. TYRA


Scout

Map No. _____ Sec. 8 Twp. 17 R. 10WWell No. 1 Frohreich_____
Nadel & Gussman _____ Company_____
Contractor

NW NE SE

E1. 1864
SECTION PLAT330 Ft. from N. Line_____
Ft. from S. Line990 Ft. from E. Line_____
Ft. from W. Line

Ellsworth County

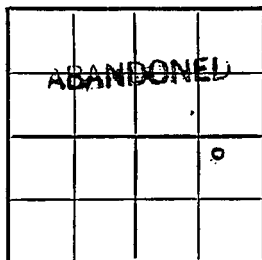

Location _____

Rig up _____

Drilling and Remarks:

8 5/8" @ 300
Heb 2888
Dodge 2911
Br L. 2999
Lane 3021
cong 3313
enb 3346

Date

D & A.

RECORD

Cased _____ in., _____ ft.

Sand _____

Gas _____

Oil _____

Total Depth 3391

PRODUCTION

1st 24 hrs. Nat. _____

1st 24 hrs. after shot _____

Gas _____ Cu. Ft.

Dry Hole _____

Abandoned _____

FEB 22 1950₁₉J. E. TYRA Scout