

KANSAS


FORM 51 5M 6-46 PETROL

McPherson county

Section 8 Township 17 Range 3-W

Well No. #5, Hogland

Company M&L Oil Company

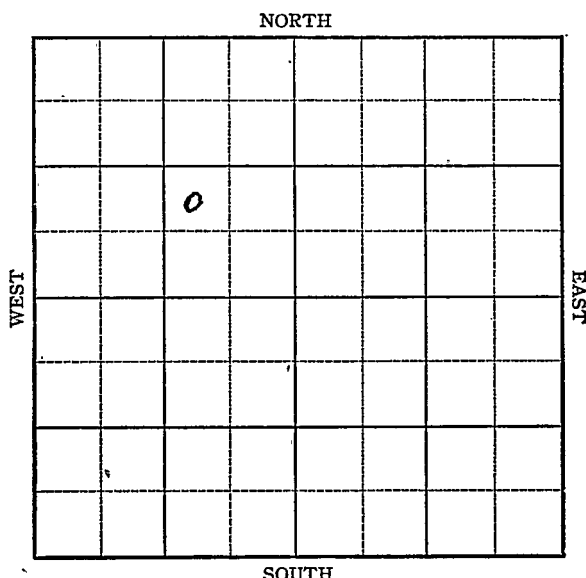

KANSAS McPherson

Sec. 8 Twp. 17-S R. 3-W

Well No. #5 Hogland Farm


M & L Oil Company

Ft. from N. Line

990 Ft. from S. Line

990 Ft. from E. Line

Ft. from W. Line

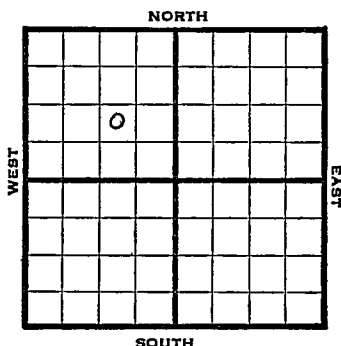

NW SE NW

1946

1336

REPORT

9/5 Location
9/10 RUR
9/18 985 Lost hole
Skid rig 35' south
12" @ 150'
8" @ 331'
Drlg 1950'
9/24 Drlg 3450'
10/1 Viola 3373'
~imp sd 3465
TD 3466'
5 " @ 3465' RUST
10/8 TD 3467-2600' oil in 8 hrs
10/15 " " "
10/29 TD 3467' - -
11/6 " "
11/12 " "
11/20 " "
11/27 Viola 3373'
Simp 3465'
5" @ 3465'
TD 3467'
Pump 389' Pot
36 Grav.

COMPLETED

KANSAS

Kansas


Pool Name LindsborgMap No. 42 Sec. 8 Twp. 17 R. 3WWell No. 5 HoglandM & L Oil Company

FIRST REPORT

Contractor

NW SE NW

SECTION PLAT

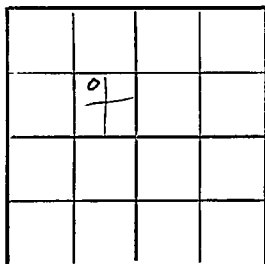 Ft. from N. Line990 Ft. from S. Line990 Ft. from E. Line Ft. from W. Line

McPherson County

Location XRig up Drilling and Remarks:

RECORD

Cased in., ft.Sand Gas Oil Total Depth

PRODUCTION

1st 24 hrs. Nat. 1st 24 hrs. after shot Gas Cu. Ft.Dry Hole Abandoned

Date

SEP 5 1946 19S. J. LEWIS Scout

Kansas

Map No. 42 Sec. 8 Twp. 17 R. 3WWell No. 5 HoglandM & L Oil

Company

COMPLETED

Contractor

NW SE NW

E. 1, 1336**SECTION PLAT**

	6		

 Ft. from N. Line990 Ft. from S. Line990 Ft. from E. Line Ft. from W. Line

McPherson County

Location Rig up

Drilling and Remarks:

Work 3323Dring 3465Sh 3465Pump 389 1st360 1st**RECORD**Cased in., ft.Sand Gas Oil Total Depth 3467**PRODUCTION**1st 24 hrs. Nat. 1st 24 hrs. after shot Gas Cu. Ft.Dry Hole Abandoned

Date

NOV 27 1946 19

S. J. LEWIS

Scout