

KANSAS


FORM 51 5M 10-41 PETROL

McPherson

Section 8 Township 17 Range 3-W

Well No. #2 Hoglund

Company M. & L. Oil

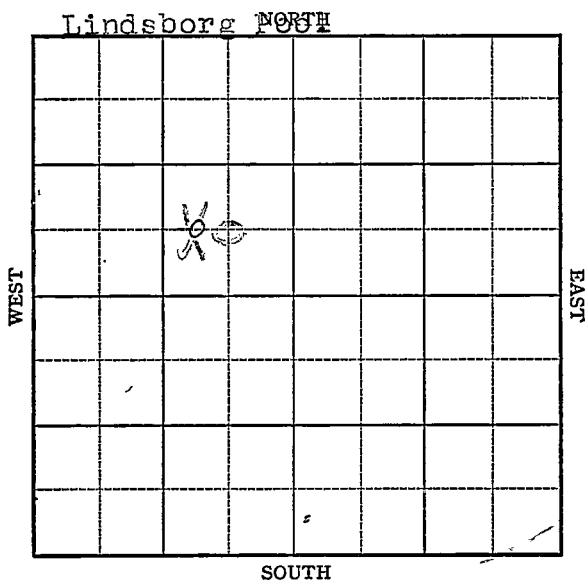


Sec. 8 Twp. 17 R. 3-WWell No. #2 Hoglund FarmM. & L. Oil Company

(Lindsborg Pool)

 Ft. from N. Line660 Ft. from S. Line660
990 Ft. from E. Line Ft. from W. Line

Elev. 1332

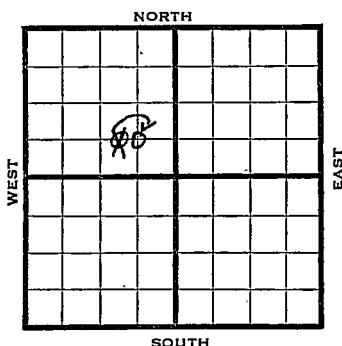

1942

REPORT

8/5 Rotary
8/12 10" @-345 WOC
8/19 10" - 345 WOC.
8/27 " "
9/2 Drlg. 700
9/9 Drlg 2080
9/16 Drlg 2906
9/23 Misener 33284 Viola 3321 TD 3327
9/30 TD 3460 tstg. filled 2000' oil $\frac{1}{2}$ hr.
10/7 Simp. sd 3450
7" - 3450
Depth Pot. 1357
T.D. 3460
Gravity 36.

COMPLETED

McPhers on

KANSAS

Map No. 42 Sec. 8 Twp. 17 R. 3WWell No. 2 HoglundM. & L. Oil

Company

FIRST REPORT

Contractor

C WL SE NW

SECTION PLAT

	0		

Ft. from N. Line

660 Ft. from S. Line990 Ft. from E. Line

Ft. from W. Line

LINDSBORG POOL

Location _____

Rig up _____

Drilling and Remarks:

Rotary*Carter sold #1 Well
and this Lease*

RECORD

Cased _____ in., _____ ft.

Sand _____

Gas _____

Oil _____

Total Depth _____

PRODUCTION

1st 24 hrs. Nat. _____

1st 24 hrs. after shot _____

Gas _____ Cu. Ft.

Dry Hole _____

Abandoned _____

Date

AUG 5 1942

19

S. J. LEWIS

Scout

McPherson

Map No. 42 Sec. 8 Twp. 17 R. 3WWell No. 2 HoglundM & I Oil CompanyCORRECTION Contractor

C SE NW

SECTION PLAT

 Ft. from N. Line660 Ft. from S. Line660 Ft. from E. Line Ft. from W. Line

	Δ		

LINDSBORG POOL

Location Rig up

Drilling and Remarks:

Reported

C WL SE NW

RECORD

Cased in., ft.Sand Gas Oil Total Depth

PRODUCTION

1st 24 hrs. Nat. 1st 24 hrs. after shot Gas Cu. Ft.Dry Hole Abandoned

Date

SEP 2 1942 19 S. J. LEWIS Scout

McPheers on

KANSAS

Map No. 42 Sec. 8 Twp. 17 R. 3WWell No. 2 HoglundM & L Oil

Company

COMPLETED

Contractor

C SE NW

 Ft. from N. Line660 Ft. from S. Line660 Ft. from E. Line Ft. from W. Line

SECTION PLAT

LINDSBORG POOL

Location Rig up

Drilling and Remarks:

*Simp Sol 3450**7" C 3450**Depth 1357**36° S*

RECORD

Cased in., ft.Sand Gas Oil Total Depth 3450

PRODUCTION

1st 24 hrs. Nat. 1st 24 hrs. after shot Gas Cu. Ft.Dry Hole Abandoned

Date

OCT 7 1942

19

S. J. LEWIS Scout