

# KANSAS

McPherson


FORM 51 5M 4-41 PETROL

Section 8 Township 17 Range 3-W

Well No. 1 Johnson

Company Auto Ordnance

NORTH Lindsborg Pool

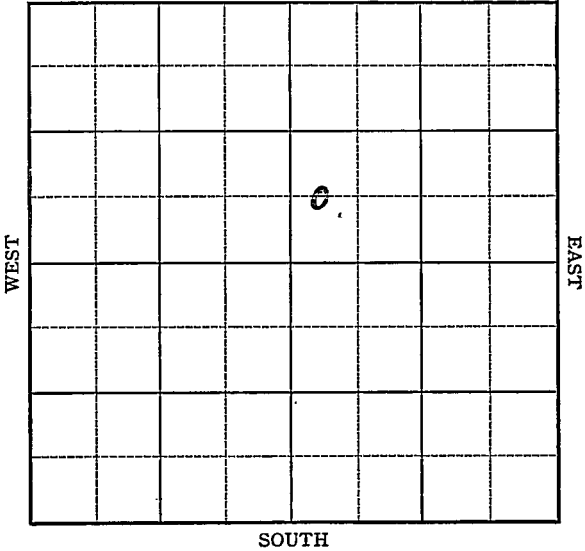

Sec. 8 Twp. 17 R. 3-W

Well No. #1 Johnson Farm

Auto Ordinance Company

(Lindsborg)


\_\_\_\_\_ Ft. from N. Line

660 Ft. from S. Line

\_\_\_\_\_ Ft. from E. Line

330. Ft. from W. Line

Elev. 1334

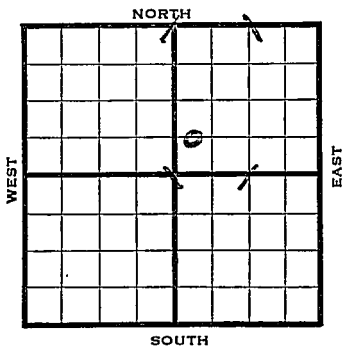

REPORT

1942

6/24

Location

7/1

10" - 350' WOC.

7/8

Drlg. 2170'

7/15

Miss. 2900' Fsg. 3055'

7/22

B. Miss. 3091 Viola 3210

Simp. sand 3451 $\frac{1}{2}$ -60 T.D.

7" @ ~~3451~~<sup>3437</sup> RUST

7/29

7" - 3437 Corrected

T.D. 3460

HFO in 6 hrs.

8/5

Simp. sd. 3451 $\frac{1}{2}$ '

7" - 3437'

TD 3460'

Depth. Pot. 2247'

Gravity 28.7

**COMPLETED**

McPher son

Map No. 42 Sec. 8 Twp. 17 R. 3W

Well No. 1 Johnson

Auto Ordnance Company

~~DRIFT REPORT~~

Contractor

FIRST REPORT

C W L S W N E


SECTION PLAT

\_\_\_\_\_ Ft. from N. Line

660 Ft. from S. Line

\_\_\_\_\_ Ft. from E. Line

330 Ft. from W. Line

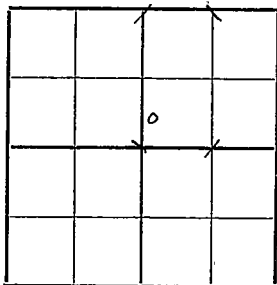

LINDSBORG POOL

Location XXX

Rig up \_\_\_\_\_

Drilling and Remarks:

*Spotted wing.*

RECORD

Cased \_\_\_\_\_ in., \_\_\_\_\_ ft.

Sand \_\_\_\_\_

Gas \_\_\_\_\_

Oil \_\_\_\_\_

Total Depth \_\_\_\_\_

PRODUCTION

1st 24 hrs. Nat. \_\_\_\_\_

1st 24 hrs. after shot \_\_\_\_\_

Gas \_\_\_\_\_ Cu. Ft.

Dry Hole \_\_\_\_\_

Abandoned \_\_\_\_\_

Date

JUN 26 1942

S. J. LEWIS

McPheers on

Map No. 42 Sec. 8 Twp. 17 R. 3WWell No. 1 Johnson

Auto Ordnance

Company

**COMPLETED**

Contractor

C WL SW NE

SECTION PLAT

\_\_\_\_\_ Ft. from N. Line

660 Ft. from S. Line

\_\_\_\_\_ Ft. from E. Line

330 Ft. from W. Line

		o	

**LINDSBORG POOL**

Location \_\_\_\_\_

Rig up \_\_\_\_\_

Drilling and Remarks:

*Comp. Sol. 345 1/2*  
*7' @ 3437*

*Depth 2247*  
*287 SW*

RECORD

Cased \_\_\_\_\_ in., \_\_\_\_\_ ft.

Sand \_\_\_\_\_

Gas \_\_\_\_\_

Oil \_\_\_\_\_

Total Depth 3460

PRODUCTION

1st 24 hrs. Nat. \_\_\_\_\_

1st 24 hrs. after shot \_\_\_\_\_

Gas \_\_\_\_\_ Cu. Ft.

Dry Hole \_\_\_\_\_

Abandoned \_\_\_\_\_

Date

AUG 5 1942 19

S. J. LEWIS Sc