

Sec. 8 Twp. 17 R. 3-W.

Well No. #2 F. E. Johnson Farm

Auto Ordnance Company
(Lindsborg Pool)


660 Ft. from N. Line

_____ Ft. from S. Line

_____ Ft. from E. Line

660 Ft. from W. Line

Elev. 1328

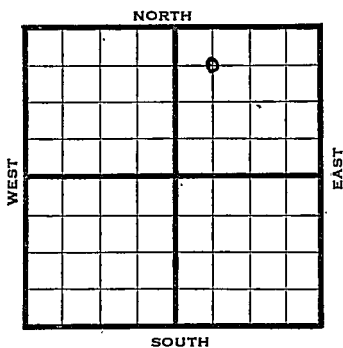

1942

REPORT

8/12 Location

8/19 Rotary

8/27 10" @ 316 Drlg 1200

9/2 8" - 393 Drlg. 2200'

9/9 Drlg 2900

9/16 Viola 3306 SSO 3308-72
Simp 3426 Simp sd 3449-51
TD 5" @ 3442 $\frac{1}{2}$ Rust

9/23 Drlg 3454 swb 60 oil per hr.

9/30 Viola 3306
Simp. 3426
Simp. Sd. 3449
5" 3442 $\frac{1}{2}$
T.D. 3454
Echo. Pot. 2179 bopd
36 grav.

COMPLETED

Map No. 42 Sec. 8 Twp. 17 R. 3W

Well No. 2 F.E. Johnson

Auto Ordnance Company

FIRST REPORT Contractor

C NW NE

660 Ft. from N. Line

_____ Ft. from S. Line

_____ Ft. from E. Line

660 Ft. from W. Line

LINDSBORG POOL

SECTION PLAT

		o	

Location X

Rig up _____

Drilling and Remarks:

RECORD

Cased _____ in., _____ ft.

Sand _____

Gas _____

Oil _____

Total Depth _____

PRODUCTION

1st 24 hrs. Nat. _____

1st 24 hrs. after shot _____

Gas _____ Cu. Ft.

Dry Hole _____

Abandoned _____

Date

AUG 12 1942 19

S. J. LEWIS Scout

Misc. Small Maps

Cards

Tracing

France Map

Scarborough Map

Moody Map

Geological Dept.

Moody Flat Book

Handwritten initials: DMS

McPherson

KANSAS

Map No. 42 Sec. 8 Twp. 17 R. 3W

Well No. 2 F. E. Johnson

Auto Ordnance Company

Contractor

C NW NE

SECTION FLAT

660 Ft. from N. Line

_____ Ft. from S. Line

_____ Ft. from E. Line

660 Ft. from W. Line

		○	

LINDSBORG POOL

Location _____

Rig up _____

Drilling and Remarks:

*Echo. Pot.
2179 Bopd*

36 grav

RECORD

Cased 5 in. 3442 1/2 ft.

Sand _____

Gas _____

Oil _____

Total Depth 3454

PRODUCTION

1st 24 hrs. Nat. _____

1st 24 hrs. after shot _____

Gas _____ Cu. Ft.

Dry Hole _____

Abandoned _____

Date **COMPLETED**

SEP 30 1942 19

S. I. LEWIS Scout

Viola 3306
Simp 3426
Simp sd 3449

Misc. Small Maps	<i>[Handwritten mark]</i>
Cards	<i>[Handwritten mark]</i>
Tracing	<i>[Handwritten mark]</i>
France Map	<i>[Handwritten mark]</i>
Scarborough	<i>[Handwritten mark]</i>
Moody Map	<i>[Handwritten mark]</i>
Geological Dept	
Mcely Hat Book	