


KANSAS

McPherson

Section 8 Township 17 Range 31W

Well No. #1 Runbeck

Company M & L Oil

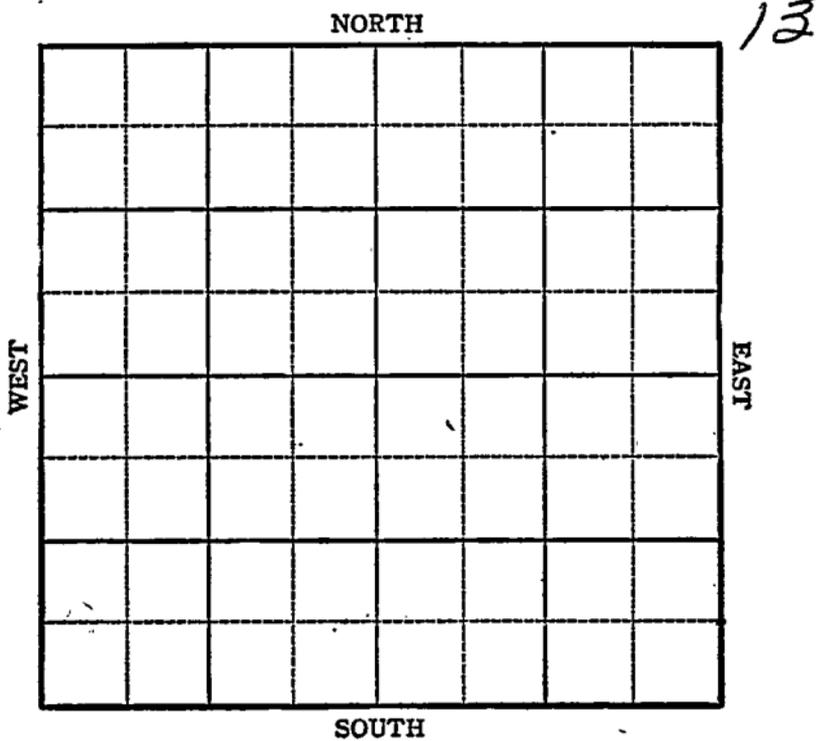

Sec. 8 Twp. 17 R. 3W

Well No. #1 Runbeck Farm

M & L Oil Company

Lindsborg


NORTH

_____ Ft. from N. Line

660 Ft. from S. Line

_____ Ft. from E. Line

330 Ft. from W. Line

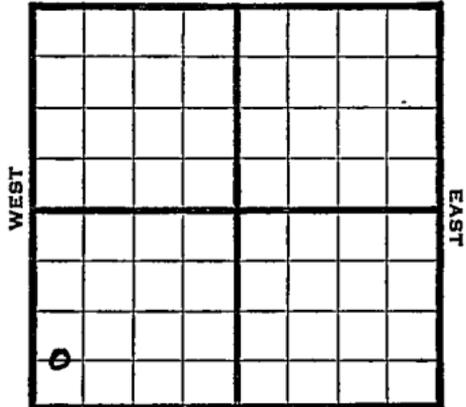

C W L SW SW *Ellis* 1337

SOUTH

1944

REPORT

8/16	Surface Hole
8/23	13" @ 183 8" @ 369 Drlg. 2171
8/30	Chat 2910 Drlg. 3035
9/8	Viola 3388 TD 5" @ 3388' RUST
9/13	" " " " "
9/21	" " " " "
9/28	" " " " "
10/4	" " " " "
10/11	TD 3415 PB 3350 333shots 3330-46 9 " 3340-46 CO
10/18	" " " " "
10/25	Squeeze Perf.
11/2	1000 acid 3393-95 No Help
11/8	" " " " "
11/15	Chat 2910 Viola 3388 5" @ 3388 Perf. Chat TD 3415 2000 acid Pump 30 oil plus 160 wtr. Pot. Grav. 36.0

COMPLETED

Pool Name Lindsborg

Map No. KANSAS 42 Sec. 8 Twp. 17 R. 3W

Well No. 1 Runbeck

M. & L. Oil Company

FIRST REPORT Contractor

C W L SW SW

SECTION PLAT

_____ Ft. from N. Line

650 Ft. from S. Line

_____ Ft. from E. Line

330 Ft. from W. Line

McPherson

Location _____

Rig up _____

Drilling and Remarks:
52 acres drill site

Surface
~~Service~~ Hole

RECORD

Cased _____ in., _____ ft.

Sand _____

Gas _____

Oil _____

Total Depth _____

PRODUCTION

1st 24 hrs. Nat. _____

1st 24 hrs. after shot _____

Gas _____ Cu. Ft.

Dry Hole _____

Abandoned _____

Date

AUG 16 1944 19

S. J. LEWIS Scout

Pool Name BlindsborgMap No. 48 Sec. 8 Twp. 17 R. 3WWell No. 1 DunbeckM. & L. Oil CompanyCOMPLETED ContractorC W L SW SW

SECTION PLAT

 Ft. from N. Line660 Ft. from S. Line Ft. from E. Line330 Ft. from W. LineMcPhersonLocation Rig up

Drilling and Remarks:

Chas 2910
Vista 3388
5" 3388
Perf Chas
2000 acid
Pump 30 oil + 160
Pf

RECORD

Cased in., ft.Sand Gas Oil Total Depth 3415

PRODUCTION

1st 24 hrs. Nat. 1st 24 hrs. after shot Gas Cu. Ft.Dry Hole Abandoned

Date

36° SNOV 15 1944 19S. J. LEWIS Scout