


Section 8 Township 17 Range 3-W

Well No. #1 Sandal

Company Auto Ordnance

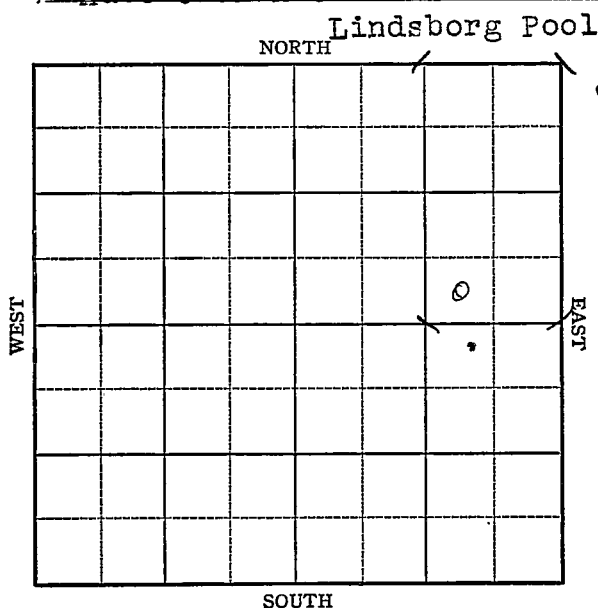

KANSAS


McPherson

Sec. 8 Twp. 17 R. 3-WWell No. #1 Sandal FarmAuto Ordnance Company

(Lindsborg Pool)

 Ft. from N. Line660 Ft. from S. Line660 Ft. from E. Line Ft. from W. Line

Elev. 1331

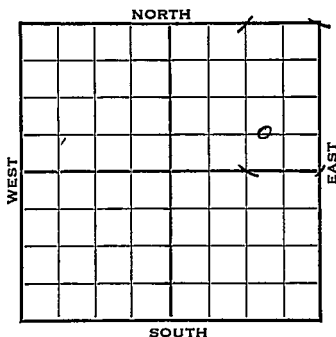

1942

REPORT

7/22	Location
7/29	13" - 173, 8" - 348 WOC
8/5	Drlg. 2442'
8/12	Miss 2891 B Miss 3098 Drlg 3290
8/19	Viola 3309 Simp. sd 3449 T.D. 3451 Sat 5" - 3442 RUST.
8/27	" " " "
9/2	TD 3457 - 3200' oil 6 hrs swab 70 oil per hr 6 hrs Gravity 28.3
9/9	Simp. sd 3449 5" - 3442 T.D. 3457 Echo Pot. 2312 Gravity 38.

COMPLETED

McPherson

KANSAS

Map No. 72 Sec. 8 Twp. 17 R. 3WWell No. 1 Sandal

Auto Ordnance

Company

FIRST REPORT

Contractor


C WL S E NE

Ft. from N. Line

660 Ft. from S. Line990 Ft. from E. Line

Ft. from W. Line

SECTION PLAT

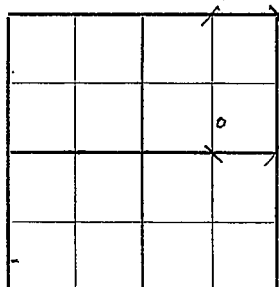

LINDSBORG POOL

Location XXX

Rig up

Drilling and Remarks:

RECORD

Cased _____ in., _____ ft.

Sand _____

Gas _____

Oil _____

Total Depth _____

PRODUCTION

1st 24 hrs. Nat. _____

1st 24 hrs. after shot _____

Gas _____ Cu. Ft.

Dry Hole _____

Abandoned _____

Date

JUL 22 1942

19

S. J. LEWIS Scout

Map No. 42 Sec. 8 Twp. 17 R. 3WWell No. 1 Sandal

Auto Ordnance

Company

COMPLETED

Contractor


C WL SE NE

Ft. from N. Line

660 Ft. from S. Line990 Ft. from E. Line

Ft. from W. Line

SECTION PLAT

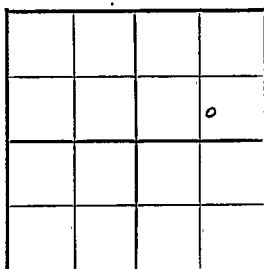

LINDSBORG POOL

Location

Rig up

Drilling and Remarks:

Simp Sol 3449
*5" C 3442**Echo 23 1/2**28° 5r*

RECORD

Cased _____ in., _____ ft.

Sand _____

Gas _____

Oil _____

Total Depth 3457

PRODUCTION

1st 24 hrs. Nat. _____

1st 24 hrs. after shot _____

Gas _____ Cu. Ft.

Dry Hole _____

Abandoned _____

Date

SEP 9 1942 19

S. J. LEWIS Scout