


Section 8 Township 17 Range 3-W

Well No. #2 Sandal

Company Auto Ordnance

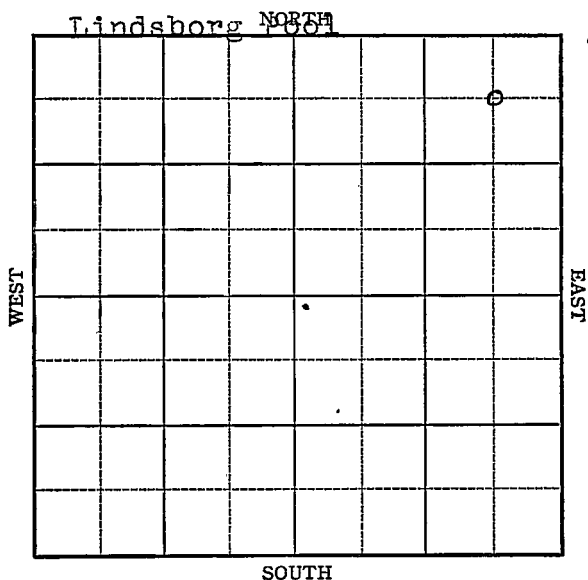


Sec. 8 Twp. 17 R. 3-WWell No. #2 Sandal Farm _____

Auto Ordnance Company

(Lindsborg Pool)

660 Ft. from N. Line Ft. from S. Line660 Ft. from E. Line Ft. from W. Line

Elev. 1331

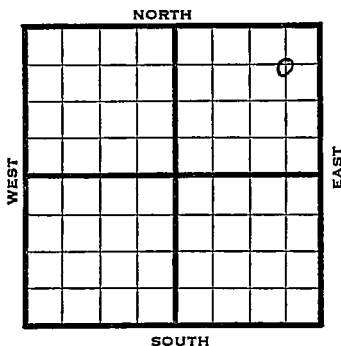

1942

REPORT

8/19 10" - 340'
Waiting on cement.

8/27 Drlg 2350

9/2 Viola 3322

Drlg. 3445'

9/9 Simp sd 3462-64 TD 7" @ 3456
Rust.

9/16 TD 3466 Inc. oil

9/23 " " " "

9/30 Viola 3322

Simp. Sh. 3443'

Simp. Dolo. 3455

Simp. Sd. 3462

7" 3456

TD 3466

Echo. pot. 2119 bopd

36 grav.

COMPLETED

Map No. 42 Sec. 8 Twp. 17 R. 3WWell No. 2 SandalAuto Ordnance CompanyFIRST REPORT ContractorC NE NE
660 Ft. from N. Line Ft. from S. Line660 Ft. from E. Line Ft. from W. Line

SECTION PLAT

			o

LINDSBORG POOLLocation Rig up

Drilling and Remarks:

10"-340'Waiting on
cement

RECORD

Cased in., ft.Sand Gas Oil Total Depth

PRODUCTION

1st 24 hrs. Nat. 1st 24 hrs. after shot Gas Cu. Ft.Dry Hole Abandoned

Date

AUG 19 1942 19 S. J. LEWIS Scout

Misc Small Maps _____
Cards... _____
Tracing... _____
France Map _____
Scarborough Map _____
Moody Map _____
Geological Dept. _____
Moody Flat Book _____

McPherson

KANSAS

Map No. 42 Sec. 8 Twp. 17 R. 3WWell No. 2 Sandal

Auto Ordnance

Company

Contractor

C NE NE

SECTION PLAT

660 Ft. from N. Line

Ft. from S. Line

660 Ft. from E. Line

Ft. from W. Line

			0

LINDSBORG POOL

Location

Rig up

Drilling and Remarks:

Echo. Pot.
2119 Bopd
36 Grav

RECORD

Cased 7 in. 34.56 ft.

Sand

Gas

Oil

Total Depth 34.66

PRODUCTION

1st 24 hrs. Nat.

1st 24 hrs. after shot

Gas ✓ Cu. Ft.

Dry Hole

Abandoned

Date **COMPLETED**

SEP 30 1942 19

S. J. LEWIS Scout

Viola 3322
Simp p Sh 3443
Simp Dolo 3455
Simp. sd 3462

Misc Small Maps	_____
Cards	_____
Tracing	_____
France Map	_____
Scarborough Map	_____
Mocoy Map	_____
Ce logical Dept.	_____
the Flat Book	_____