

KANSAS


McPherson

Section 8 Township 17 Range 3W

Well No. 3 Sandal

Company Fikes et al

Lindsborg
NORTH

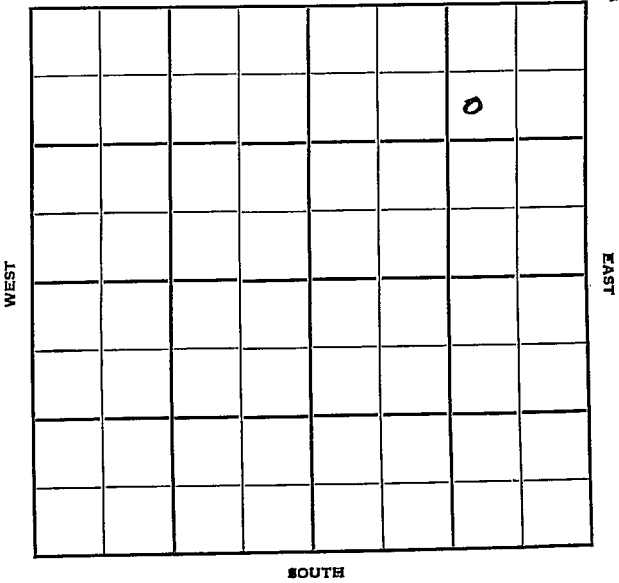

Sec. 8 Twp. 17 R. 3W ✓

Well No. 3 Sandal Farm _____

Fikes et al

Company

Lindsborg Pool

Carey-Contr. ^{NORTH}


990 Ft. from N. Line

_____ Ft. from S. Line

990 Ft. from E. Line

_____ Ft. from W. Line

SW NE NE

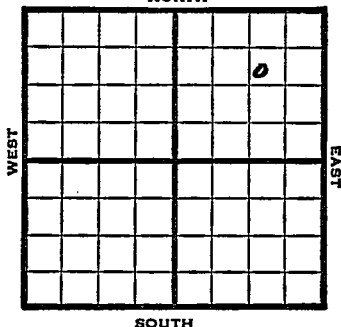

1949

Elv. 1330' REPORT

9/28

RUR

10/5

13" @ 174

Drlg 1585'

10/12

KC 2390'

Miss 2900'

Drlg 3018'

10/19

Miss 2890'

Viola 3310'

Simpson sand 3450'

TD 3474'

5" @ 3474'

10/26

"

11/1

"

11/9

Plug 3410'

18 shots 3314-17 - 1500 acid

Pump 10 bbls oil a day

11/16

"

11/23

"

11/29

"

12/7

"

12/14

"

12/21

"

12/27

"

1950

2/1

TD 3474'

13" @ 174'

5" @ 3474'

Plug back to 3400'

P 10 BOPD

Comp

COMPLETED

Map No. _____ Sec. 8 Twp. 17 R. 3W

Well No. 3 Sandal

Fikes et al. _____ Company

Carey _____ Contractor

SW NE NE

FIRST REPORT
SECTION PLAT

990 Ft. from N. Line

_____ Ft. from S. Line

990 Ft. from E. Line

_____ Ft. from W. Line

| | | | |
|--|--|--|---|
| | | | |
| | | | o |
| | | | |
| | | | |
| | | | |

McPherson County

Location _____

Rig up _____

Drilling and Remarks:

R U R

RECORD

Cased _____ in., _____ ft.

Sand _____

Gas _____

Oil _____

Total Depth _____

PRODUCTION

1st 24 hrs. Nat _____

1st 24 hrs. after shot _____

Gas _____ Cu. Ft.

Dry Hole _____

Abandoned _____

Date

SEP 28 1949

19

S. J. LEWIS

Scout

Map No. _____ Sec. 8 Twp. 17 R. 3WWell No. 3 Sandal

_____ Fikes etal. _____ Company

Contractor


SW NE NE

E. 1330
SECTION PLAT990 Ft. from N. Line

_____ Ft. from S. Line

990 Ft. from E. Line

_____ Ft. from W. Line

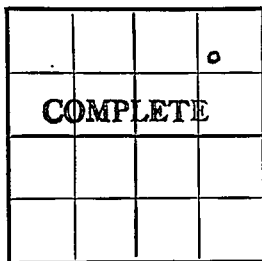

McPherson County

Location _____

Rig up _____

Drilling and Remarks:

13" @ 174
5" @ 3474
plug back to 3400
~~*Pt 34*~~
P-10 BOPD

RECORD

Cased _____ in., _____ ft.

Sand _____

Gas _____

Oil _____

Total Depth 3474

PRODUCTION

1st 24 hrs. Nat. _____

1st 24 hrs. after shot _____

Gas _____ Cu. Ft.

Dry Hole _____

Abandoned _____

Date

FEB 1 1950

19

D. E. TYRA

Scout