

KANSAS

McPherson

Section 8 Township 17 Range 3W

Well No. 2 Community "B"


Company William White

Lindsborg Pool

NORTH

WEST

EAST

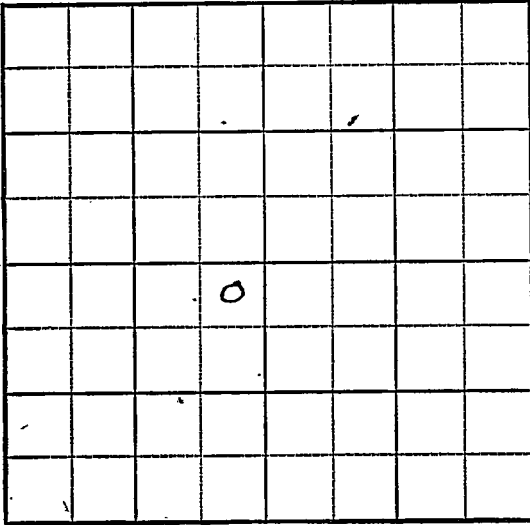

SOUTH

//

Sec. 8 Twp. 17 R. 3W

Well No. 2 Community "B" Farm

William White Company


Lindsborg Pool

330 Ft. from N. Line

_____ Ft. from S. Line

330 Ft. from E. Line

_____ Ft. from W. Line

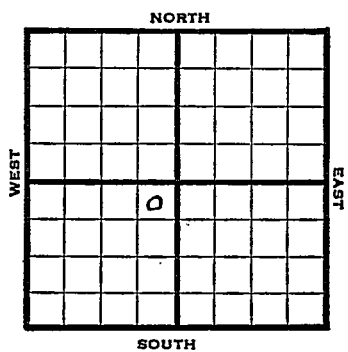

NE SW

1948

Eli 1339' REPORT

9/22

13" @ 175'
8" @ 350'
Drilling 1820'

9/29

Miss 2903'
Viola 3380'
Drlg 3405'

10/6

Simpson sd 3471'
Arb 3519'
5" @ 3527'
21 shots 3468-75 SO
Miss 2910'

10/13

"

10/19

"

10/27

TD 3529'
Simp Sd 3471'
Arb. 3519'
5" @ 3527'
Perf Simp
Pump 764 oil / 25% W Pot
38° Gr.
Comp

COMPLETED

Kansas

Map No. 42 Sec. 8 Twp. 17 R. 3W

Well No. 2 Community "B"

William White Company

COMPLETE

Contractor

NE SW

E1, 1339
SECTION PLAT

330 Ft. from N. Line

_____ Ft. from S. Line

330 Ft. from E. Line

_____ Ft. from W. Line

	o		

McPherson County

RECORD

Location _____

Cased _____ in., _____ ft.

Rig up _____

Sand _____

Drilling and Remarks:

Gas _____

Sample Scl 3471
Cr 43519
5' @ 3527.
Prof. Sample
Pump 764 oil +
25% N Pot 38% S

Oil

Total Depth 3529

PRODUCTION

1st 24 hrs. Nat. _____

1st 24 hrs. after shot _____

Gas _____ Cu. Ft.

Dry Hole _____

Abandoned _____

Date

OCT 27 1948 19

S. J. LEWIS Scout