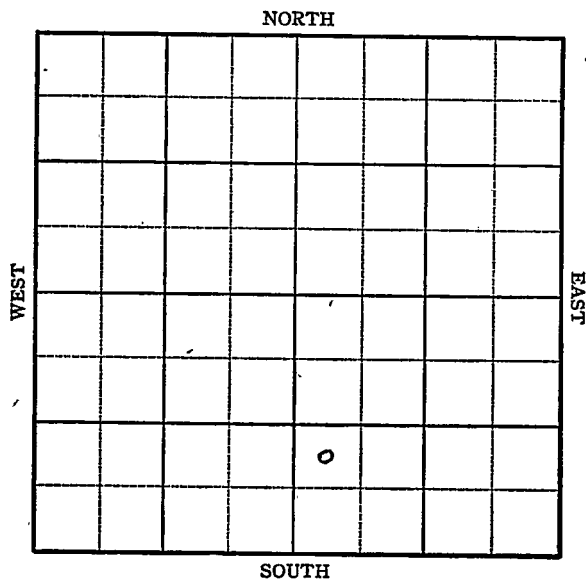


KANSAS

McPherson

Section 8 Township 17 Range 3-WWell No. #1 CommunityCompany C.U. Bay

KANSAS

McPherson County

Sec. 8 Twp. 17 R. 3W

Well No. #1 Community Farm

C. U. Bay Company

Lindsborg


 Ft. from N. Line

990 Ft. from S. Line

 Ft. from E. Line

330 Ft. from W. Line

NW SW SE

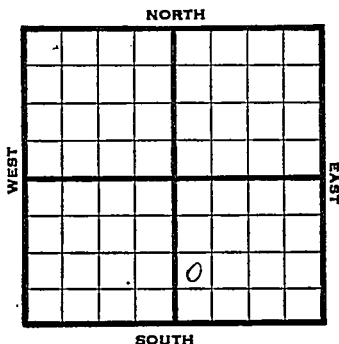

1945 Elev. 1333' REPORT

12/19 13" @ 170' WOC

12/29 8" - 362' Drlg. 2410'

1946

1/10 Viola 3367' Simp Sand 3460'
T.D. 3462' 5" - 3460' RUST.

1/17 T.D. 3463' 3200' oil 5 hrs.

1/24 " " "

1/31 " " "

2/7 " " "

2/14 " " "

2/20 Simp Sd. 3460

5" @ 3460

TD 3463'

Pump 462 Pot.


Grav. 36.0

COMPLETED

KANSAS~~Kansas~~ Pool Name LindsborgMap No. K-42 Sec. 8 Twp. 17 R. 3WWell No. 1 CommunityC. U. Bay CompanyFIRST REPORT Contractor

NW SW SE

SECTION PLAT

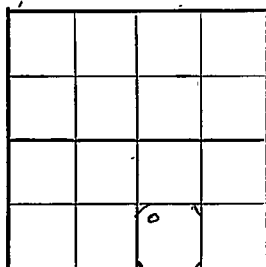 Ft. from N. Line990 Ft. from S. Line Ft. from E. Line330 Ft. from W. LineMcPherson CountyLocation Rig up

Drilling and Remarks:

13"-170 WOC

RECORD

Cased in., ft.Sand Gas Oil Total Depth

PRODUCTION

1st 24 hrs. Nat. 1st 24 hrs. after shot Gas Cu. Ft.Dry Hole Abandoned

Date

DEC 19 194519S. J. LEWIS Scout

KANSAS Kansas Pool Name Lindsborg
 Map No. 42 Sec. 8 Twp. 17 R. 3W
 Well No. 1 Community

C.U. Bay Company

COMPLETEL

Contractor

NW SW SE

E1,1333
SECTION PLAT

		0	

Ft. from N. Line

990

Ft. from S. Line

Ft. from E. Line

330

Ft. from W. Line

McPherson County

Location /

Rig up

Drilling and Remarks:

Single Shot 3460
510 3460

Pump 462 Bt

36° E

RECORD

Cased in., ft.

Sand

Gas

Oil

Total Depth 3463

PRODUCTION

1st 24 hrs. Nat.

1st 24 hrs. after shot

Gas Cu. Ft.

Dry Hole

Abandoned

Date

180

FEB 20 1946

19

S. J. LEWIS

Scout