


Section 8 Township 17 Range 3 W

Well No. #2 Community "A"

Company Tennessee Gas & Transmission

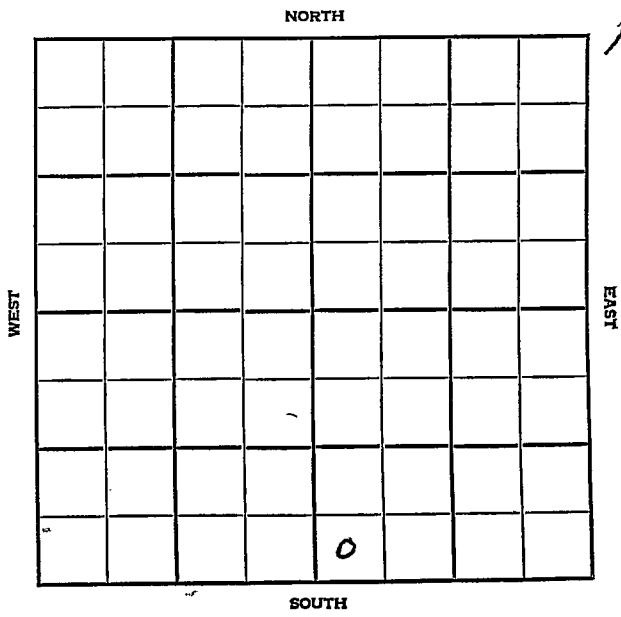

SEC.	TWP.	R.
8	17	3W

WELL NO.

#2 Community "A"

FARM

COMPANY

Tennessee Gas &amp; Transmission

CONTRACTOR

Sterling

Lindsborg


\_\_\_\_\_ Ft. from N. Line

\_\_\_\_\_ Ft. from S. Line

\_\_\_\_\_ Ft. from E. Line

\_\_\_\_\_ Ft. from W. Line

SW SW SE

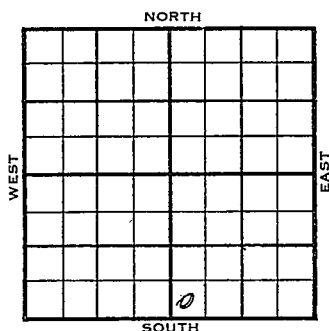

	ELEVATION	REPORT
1956	1331	
2-22	RUR	
4-11	Comm. 2-21-56 13 3/8" @ 160 w/175 5 1/2" @ 3452 DD 3456 FU 1000' oil, 90 min, P/ 161 bo 16 hrs. Comp. 175 bopd Log tops: M. 2889 Mq. 3319 V. 3367 S. 3451 TD 3453'	

COMPLETED

County McPherson Elev. \_\_\_\_\_  
 Sec. 8 Twp. 17 Rge. 3W  
 Company Tennessee Gas & Transmission  
 FarmName Community "A" No. 2

TOPS	DEPTH	LOG	DATUM	Loc. in Sec.
Anh.				SW SW SE
TP.				
H.				
Tr.				
Dg.				
Bl.				
L.				Geol. _____
K.C.				Contr. _____
B.K.C.				
Ce.				<u>Sterling</u>
C.				
M.				Pool _____
M.				<u>Lindsborg</u>
K.				
Mz.				
Mq.				
V.				
S.				
S.				
A.				
R.				
PE.				
G.				
T.D.				

FIRST REPORT  
 FEB 22 '56  
 0

Date Comm. RUR

\_\_\_\_\_  
 \_\_\_\_\_  
 \_\_\_\_\_  
 \_\_\_\_\_  
 \_\_\_\_\_  
 \_\_\_\_\_  
 \_\_\_\_\_

Co.  
 Loc.  
 No.  
 Sec.  
 T.  
 R.

County McPherson Elev. 1331  
 Sec. 8 Twp. 17 Rge. 3W  
 Company Tennessee Gas & Transmission  
 Farm Name Community "A" No. 2

TOPS	DEPTH	LOG	DATUM	Loc. in Sec.
Anh.				SW SW SE
Tp.				
H.				
Tr.				375' SL
Dg.				180' WL
Bl.				
L.				
K.C.				Geol.
B.K.C.				Contr.
Ce.				
C.				Sterling
M.		2889	1558	
M.				Pool
K.				Lindsborg
Mz.				
Mo.		3319	1988	
V.		3367	2036	
S.		3457	2120	
S.				
A.				
R.				
PE.				
G.				
T.D.	3453			

COMPLETE

Date Comm. 2-21-56 APR 1 1 1956  
13 3/8" @ 160/175 5 1/2" @ 3452 DD 3456  
FU 1000' oil 90 min. P/ 161 bo 16 hr.  
Comp. 175 bopd