

KANSAS


McPherson county

FORM 51 5M 6-46 PETROL

Section 8 Township 17 Range 3-W

Well No. #1, Community "B"

Company C. U. Bay

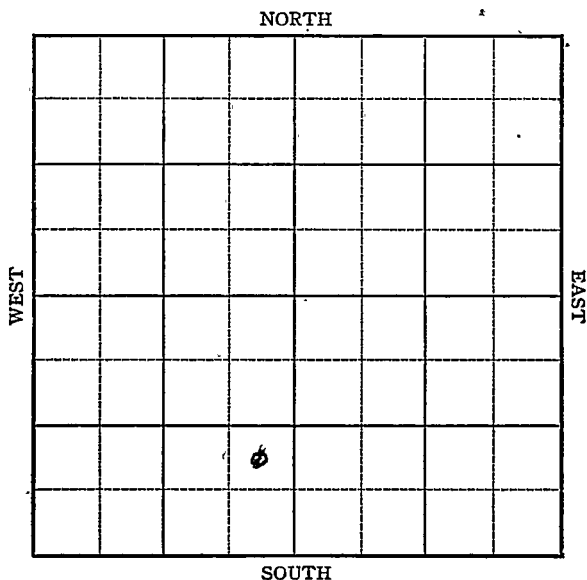

Sec. 8 Twp. 17 R. 3W

Well No. #1 Community "B" Farm

C. U. B ay Company

Lindsberg


 Ft. from N. Line

990 Ft. from S. Line

330 Ft. from E. Line

 Ft. from W. Line

NE SE SW

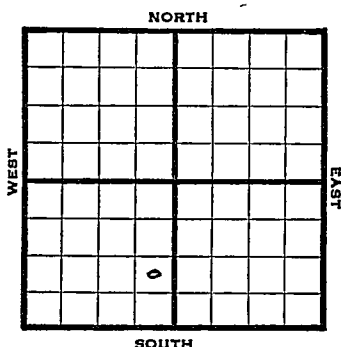

1946

1330

REPORT

9/11 Location

9/18 12" @ 175'

8" @ 350

Drlg 705'

9/24 Drlg 3185'

10/1 Lans 2218'

Miss 2903

Simp sd 3457

TD3458

5" @ 3457 1/2 RUST

10/8 740' oil in 12 hrs

10/15 " " "

10/22 " " "

10/30 Simp 3457'

5" @ 3457 1/2'

TD 3458'

Pump 305 POT


36 Grav.

COMPLETED

Kansas Pool Name LindsbergMap No. 42 Sec. 8 Twp. 17 R. 3WWell No. 1 Community "B"C. U. Bay CompanyFIRST REPORT Contractor

NE SE SW

SECTION PLAT

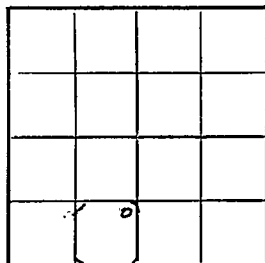 Ft. from N. Line990 Ft. from S. Line330 Ft. from E. Line Ft. from W. LineMcPherson CountyLocation XRig up

Drilling and Remarks:

RECORD

Cased in., ft.Sand Gas Oil Total Depth

PRODUCTION

1st 24 hrs. Nat. 1st 24 hrs. after shot Gas Cu. Ft.Dry Hole Abandoned

Date

9-111946S. J. LEWIS


Scout

Kansas

Map No. 42 Sec. 8 Twp. 17 R. 3WWell No. 1 Community "B"C. U. Bay Company**COMPLETED**

Contractor

NE SE SW

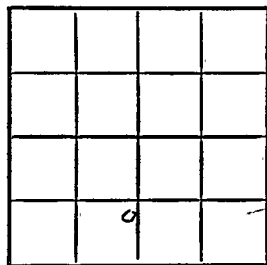E1, K30
SECTION PLAT Ft. from N. Line990 Ft. from S. Line330 Ft. from E. Line Ft. from W. Line

McPherson County

Location Rig up

Drilling and Remarks:

*Surf 3457**5/2 3457 1/2**Pump 305 BX**36° Gr***RECORD**Cased in., ft.Sand Gas Oil Total Depth 3458**PRODUCTION**1st 24 hrs. Nat. 1st 24 hrs. after shot Gas Cu. Ft.Dry Hole Abandoned

Date

OCT 30 1946 19 S. J. LEWIS Scout