
KANSAS McPherson

FORM 51 5M PETROL

Section 8 Township 17 Range 3W

Well No. 3 Fagerberg

Company Bay Pet.

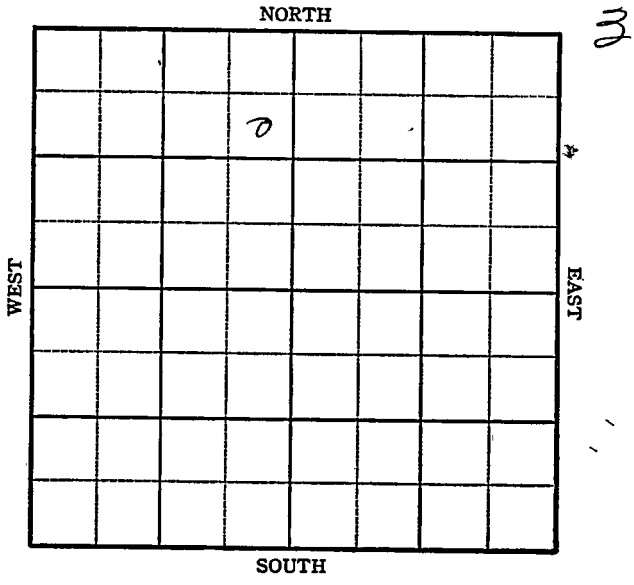

FORM 252-A
5M 8-45 PETROL

KANSAS McPherson

Sec. 8 Twp. 17 R. 3-W

Well No. #3 Fagerberg Farm

Bay Pet. Company


990 Ft. from N. Line

Ft. from S. Line

330 Ft. from E. Line

Ft. from W. Line

SE NE NW

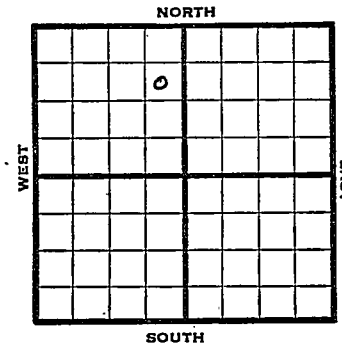

1945	Elev. 1335 REPORT
10/24	Location
10/31	12" @ 167
	8" @ 320 WOC
11/7	Drlg. 2560'
11/14	Viola 3369-3372
	TD 3372
	5" @ 3371 RUST
11/21	" " "
11/28	TD 3462
	4½" liner @ 3461
12/5	Simp. 3461
12/12	3000' oil 3 hrs.
12/20	" "
12/29	" "
1946	
1/10	" "
1/17	" "
1/23	Viola 3369
	5" @ 3371
	Simp Sd. 3461
	TD 3462
	Pump 263 Pot.
	Grav. 36.0

COMPLETED

FORM 26 200 BKS 1-44 PETROL

KANSAS Kansas Pool Name Lindsborg

Map No. 42 Sec. 8 Twp. 17 R. 3W

Well No. 3 Fagerberg

Bay Pet. Company

FIRST REPORT Contractor

SE NE NW


990 Ft. from N. Line

Ft. from S. Line

330 Ft. from E. Line

Ft. from W. Line

SECTION PLAT

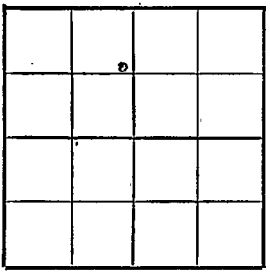

McPherson County

Location x

Rig up

Drilling and Remarks:

RECORD

Cased in., ft.

Sand

Gas

Oil

Total Depth

PRODUCTION

1st 24 hrs. Nat.

1st 24 hrs. after shot.

Gas Cu. Ft.

Dry Hole

Abandoned

Date

OCT 24 1945 19 S. J. LEWIS Scout

FORM 26 200 BKS 1-44 PETROL

KANSAS Kansas Pool Name Lindsborg

Map No. 4/2 Sec. 8 Twp. 17 R. 3W

Well No. 3 Fagerberg


Bay Pet. Company

COMPLETED Contractor

SE NE NW

El. 1335

SECTION PLAT

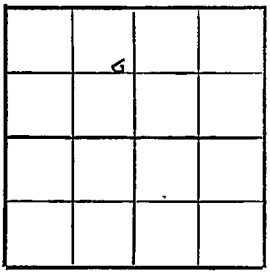

990 Ft. from N. Line

Ft. from S. Line

330 Ft. from E. Line

Ft. from W. Line

McPherson

Location

Rig up

Drilling and Remarks:

Viola 3369

5" @ 3371

Simp Sd 3461

Dunn 2683 BX

36° Gr

RECORD

Cased in., ft.

Sand

Gas

Oil

Total Depth 3462

PRODUCTION

1st 24 hrs. Nat.

1st 24 hrs. after shot

Gas Cu. Ft.

Dry Hole

Abandoned

Date

JAN 23 1946 19

S. J. LEWIS Scout