
FORM 51 25M 3-49 PETROL

KANSAS McPherson

Section 8 Township 17 Range 3-W

Well No. #4 Fagerberg

Company Bay Pet

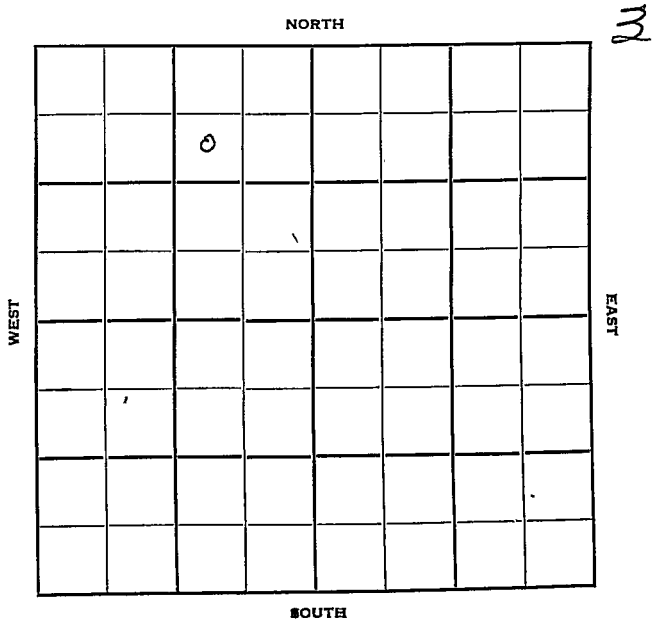

FORM 252-B
10M 9-49 PETROL

KANSAS McPherson

Sec. 8 Twp. 17 R. 3-W

Well No. #4 Fagerberg Farm

Bay Pet. Company

Pickrell Drlg. Contractor

Lindsborg


990 Ft. from N. Line

Ft. from S. Line

990 Ft. from E. Line

Ft. from W. Line

SW NE NW

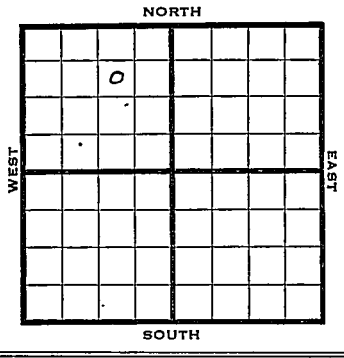

1950	REPORT
	Elev 1338
7/19	Spud 7-13-50
	13" @ 167
	8" @ 377
	drlg 735
8/30	13" @ 167
	8" @ 377
	Miss chat 2905 Maq 3327
	Viola 3374 Simp 3461-63
	5½" @ 3461
	TD 3463
	FU 1000' fluid10 hr
	15% wtr
	PB 3459
	10 gwph shot w/Dowell
	DP to 3465
	½ bo 10 gwph
	4 qt 3461-64 FU 1800' wtr 100' oil
	SP 3415
	35/3384-90 500 A 2boph
	FU 70' wtr 1 goph SP 3358
	36/3328-34
	1000 A FU 100' fluid ph mostly wtr
	TD 3465
	D&A
	ABANDONED

Form 26 200 Bks. 11-49 Petrol

Kansas

Lindsborg

Map No. ____ Sec. 8 Twp. 17 R. 3W

Well No. 4 Fagerberg

Bay Pet. Company

Pickrell Drlg. Contractor

SW NE NW

990 Ft. from N. Line


____ Ft. from S. Line

990 Ft. from E. Line

____ Ft. from W. Line

McPherson County

SECTION PLAT

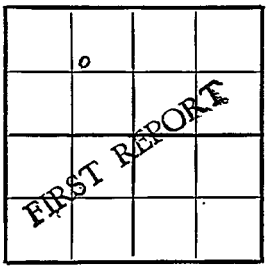

Location ____

Rig up ____

Drilling and Remarks:

Spud 7-13-50

13" @ 167

8" @ 377

drlg. 735

RECORD

Cased ____ in., ____ ft.

Sand ____

Gas ____

Oil ____

Total Depth ____

PRODUCTION

1st 24 hrs. Nat. ____

1st 24 hrs. after shot ____

Gas ____ Cu. Ft.

Dry Hole ____

Abandoned ____

Date

JUL 19 1950

19 ____

J. E. TYRA Scout

FORM 275 FOR SALE BY KANSAS BLUE PRINT CO.


County McPherson State Kansas

Sec. 8 (Blk. Twp.) 17 (Sur. Rge.) 3W Map No.

Operator Bay Petroleum

Well No. 4 Farm Fagerberg

Elev. 1338 Location SW NE NW

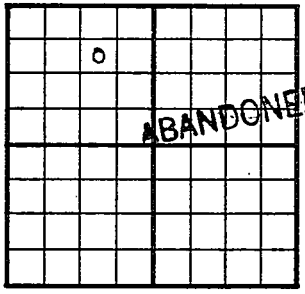

990 Ft. From N Line NW

990 Ft. From E Line Quarter

1st. Report

Completion AUG 30 1950

Remarks Lindsborg Pool

Spudding Date 7-13-50

Drlg. Data D & A TD 3465

13" @ 167 8" @ 377 Miss. chat 2905

Maq. 3327 Viola 3374 Simp. 3461-63

5½" @ 3461 TD 3463 FU 1000' fluid 10 hr.

15% water PB 3459 10 gwph Shot w/

Dowell DP to 3465 ½ bo 10 gwph

4 qt. 3461-64 FU 1800' water 100' oil

SP 3415 35/ 3384-90 500 A 2 goph

FU 70' water 1 goph. SP 3358. 36/ 3328-34

1000 A FU 100' fluid ph mostly water

D & A

J. E. TYRA