

KANSAS

FORM 51 5M 10-41 PETROL

McPherson

Section 8 Township 17 Range 3-W

Well No. #2 Fargerberg

Company Bay Petroleum


Lindsborg Pool

NORTH

m

WEST

EAST

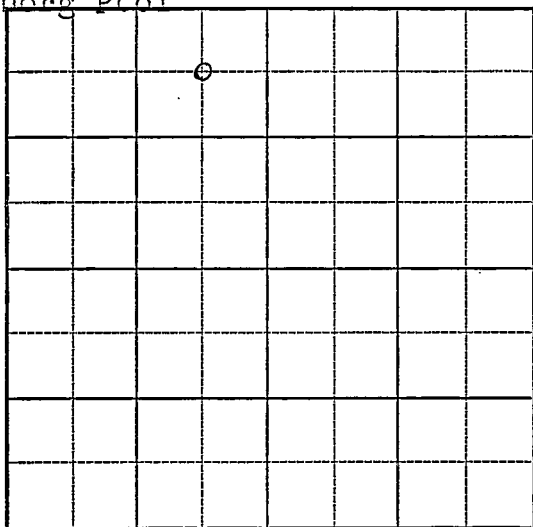

SOUTH

Sec. 8 Twp. 17 R. 3-W

Well No. #2 Fargerberg Farm

Bay Petroleum Company

(Lindsborg Pool)


660 Ft. from N. Line

_____ Ft. from S. Line

660 Ft. from E. Line

_____ Ft. from W. Line

Elev. 1336

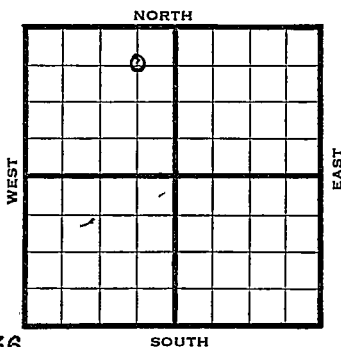

1942

REPORT

8/12

Location

8/19

8" - 338 Drlg. 1770'

8/27

Drlg 2995

9/2

Viola 3322

Simp Sat 3457-68 T.D.

5" - 3457 RUST.

9/9

" " "

9/16

3200' oil in 4 hr.

9/23

Simp. Sd. 3457

5" 3457

TD 3468

Depth 2261 Pot.

36 Gr.

COMPLETED

Map No. 42 Sec. 8 Twp. 17 R. 3W

Well No. 2 Fargerberg

Bay Petroleum Company

FIRST REPORT Contractor

C NE NW

660 Ft. from N. Line

_____ Ft. from S. Line

660 Ft. from E. Line

_____ Ft. from W. Line

SECTION PLAT

	D		

LINDSBORG POOL

Location X

Rig up _____

Drilling and Remarks:

RECORD

Cased _____ in., _____ ft.

Sand _____

Gas _____

Oil _____

Total Depth _____

PRODUCTION

1st 24 hrs. Nat. _____

1st 24 hrs. after shot _____

Gas _____ Cu. Ft.

Dry Hole _____

Abandoned _____

Date

AUG 12 1942

KANSAS

Map No. 42 Sec. 8 Twp. 17 R. 3W

Well No. 2 Fargerberg

Bay Petroleum Company

COMPLETED

Contractor

C NE NW

660 Ft. from N. Line

Ft. from S. Line

660 Ft. from E. Line

Ft. from W. Line

SECTION PLAT

	o		

LINDSBORG POOL

RECORD

Location _____

Cased _____ in., _____ ft.

Rig up _____

Sand _____

Drilling and Remarks:

Gas _____

Oil _____

Simp Sol 3457

Total Depth 3468

5" c 3457

Tests 2261 RD

PRODUCTION

1st 24 hrs. Nat. _____

1st 24 hrs. after shot _____

Gas _____ Cu. Ft.

Dry Hole _____

Abandoned _____

360 Gr

Date

SEP 23 1942 19

S. J. LEWIS Scout