

KANSAS


FORM 51 5M 10-41 PETROL

McPherson

Section 9 Township 17 Range 3-W

Well No. #2 Melander

Company Auto Ordnance  
Lindsborg Pool

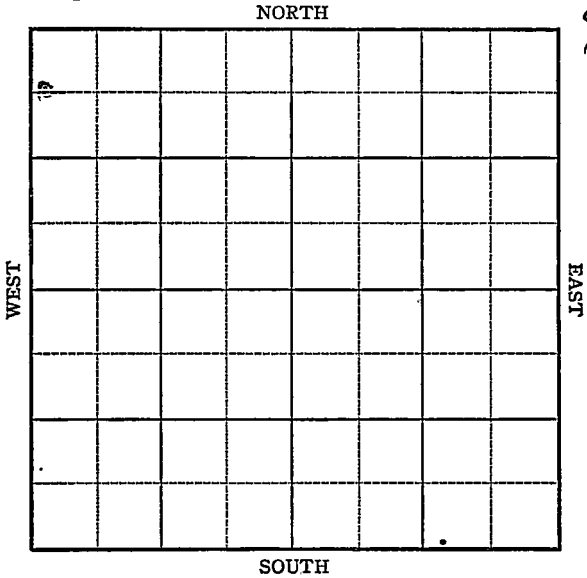

Sec. 9 Twp. 17 R. 3W

Well No. 2-Melander Farm

Auto Ordnance Company


(Lindsborg pool)

660 Ft. from N. Line

\_\_\_\_\_ Ft. from S. Line

\_\_\_\_\_ Ft. from E. Line

330 Ft. from W. Line

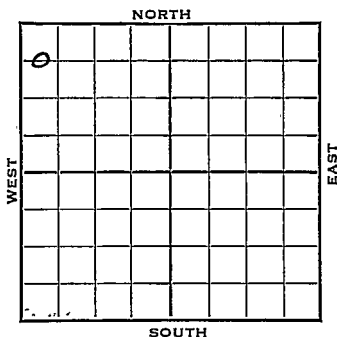

Elev. 1330

1942

REPORT

9/23

Location

9/30

TD 317 WOC. 15" - 167. 8" - 317'

10/7

10" - 317 Drlg. 2395

10/14

Drlg. 3300'

10/21

Viola 3340  
Simp. sd. 3476  
T.D. 3490  
No shows.

**ABANDONED**

KANSAS

McPhereson

Map No. 42 Sec. 9 Twp. 17 R. 3WWell No. 2 Melander

Auto Ordnance

Company

**FIRST REPORT**

Contractor

C  $W\frac{1}{2}$  NW NW**SECTION PLAT**660 Ft. from N. Line         Ft. from S. Line         Ft. from E. Line330 Ft. from W. Line

|   |  |  |  |
|---|--|--|--|
| 0 |  |  |  |
|   |  |  |  |
|   |  |  |  |
|   |  |  |  |

**LINDSBORG POOL**Location XXXRig up         Drilling and Remarks:         **RECORD**Cased          in.,          ft.Sand         Gas         Oil         Total Depth         **PRODUCTION**1st 24 hrs. Nat.         1st 24 hrs. after shot         Gas          Cu. Ft.Dry Hole          Abandoned         

Date

SEP 23 1942 19S. J. LEWIS Scout

Map No. cb Sec. 9 Twp. 17 R. 3WWell No. 2 Melander

Auto Ordnance

Company

ABANDONED

Contractor

C  $W\frac{1}{2}$  NW NW

## SECTION PLAT

660 Ft. from N. Line

Ft. from S. Line

Ft. from E. Line

330 Ft. from W. Line

|   |  |  |  |
|---|--|--|--|
| D |  |  |  |
|   |  |  |  |
|   |  |  |  |
|   |  |  |  |

LINDSBORG POOL

Location \_\_\_\_\_

Rig up \_\_\_\_\_

Drilling and Remarks:

*Vista 3340*  
*Comp. Sol. 3476*  
*Nrs howe*

## RECORD

Cased \_\_\_\_\_ in., \_\_\_\_\_ ft.

Sand \_\_\_\_\_

Gas \_\_\_\_\_

Oil \_\_\_\_\_

Total Depth 3490

## PRODUCTION

1st 24 hrs. Nat. \_\_\_\_\_

1st 24 hrs. after shot \_\_\_\_\_

Gas \_\_\_\_\_ Cu. Ft.

Dry Hole \_\_\_\_\_

Abandoned \_\_\_\_\_

Date

OCT 21 1942 19

S. J. LEWIS Scout