


Section 9 Township 17 Range 8W

Well No. 9 H. W. Mollhagen

Company Continental Oil

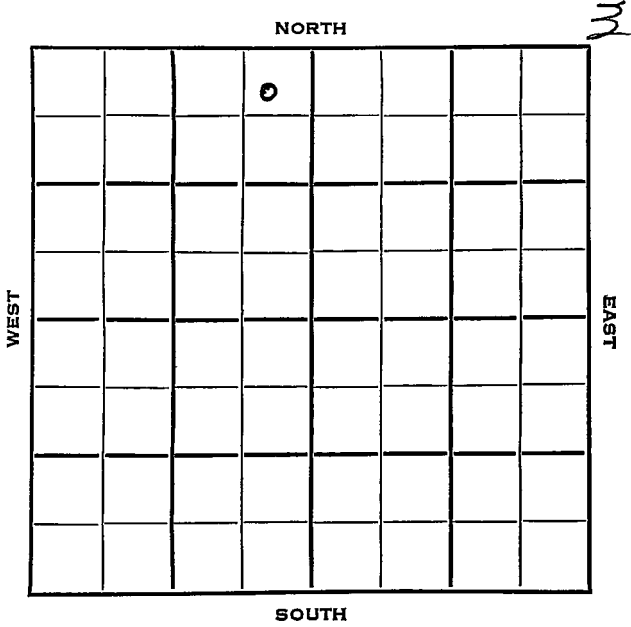

Ellsworth KANSAS

SEC.	9	TWP.	17	R.	8W ✓
------	---	------	----	----	------

WELL NO. 9 H. W. Mollhagen FARM

COMPANY Continental Oil

CONTRACTOR Anschutz


N. Edwards Pool

440 Ft. from N. Line

Ft. from S. Line

Ft. from E. Line

2200 Ft. from W. Line

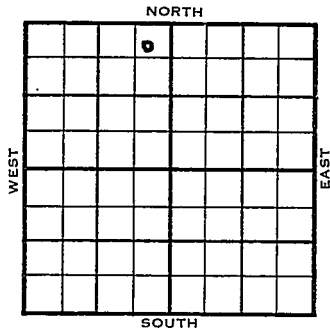

NE NE NW

1954	ELEVATION 1689'	REPORT
------	--------------------	--------

2/17 Spud 2-13-54
8" @ 320'

Dr1g. 11433'

2/24 Heeb 2611', Br li 2729', Lans 2743',
B KC 3016', Cong 3101', Bew Arb. 3177',
Arb. 3198'

RTD 3248' Schl

3/3 5" @ 3242'
CO 3227'

56/3192-3206',

S/2 bo 4 hrs., 500A
S/48 BO 3 hrs.

3/10 NR

3/17 NR

3/24 Spud 2-13-54
Oil Well

TD 3248'
8" @ 320'

Heeb 2611', Br line 2729', Lans 2743',

B KC 3066', Cong 3101', ReArb. 3177',
Arb. 3198'

TD 3248'
5" @ 3242'

CO to 3227', 56/3192-3206', S/2 bo
4 hr., 500A, S/48 bo 3 hrs.

Comp. 346 bopd **COMPLETED**

