


Section 9 Township 17 Range 8W

Well No. 2 Molhagen (Mollhagen)

Company Continental Oil

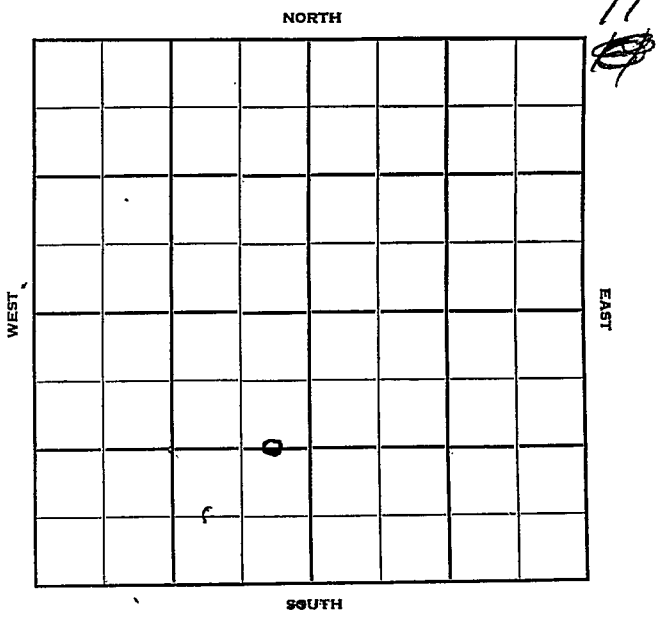

Sec. 9 Twp. 17 R. 8 W ✓

Well No. # 2 Møhlhagen Farm

Continental Oil Company

Contractor

Edwards Pool


Ft. from N. Line

1320 Ft. from S. Line

Ft. from E. Line

2200 Ft. from W. Line

C E L $E\frac{1}{2}$ SW

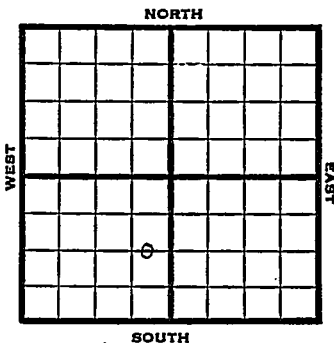

1951 Elev. 1717' REPORT

7/18 R U R

9/12 Spud 7-18-51

Oil well TD 3247' 10" @ 306'
 Heeb 2632' Br. line 2754' Lans 2774'
 Cong. 3128' Arb. 3202' TD 3210'
 CO to 3246' FU 3075' oil DD 3247'
 S/61 BOPH 2 hr.
 Comp. draw down pot. 3000 BOPD

COMPLETED

County Ellsworth State Kansas

Sec. 9 (Blk. Twp.) 17 (Sur. Rge.) 8W Map No.

Operator Continental Oil

Well No. 2 Farm Mollhagen

Elev. _____ Location C E L $\frac{1}{2}$ SW

1320 Ft. From S Line SW

2200 Ft. From W Line Quarter

Ist. Report JUL 18 1951

Completion _____

Remarks _____

Spudding Date _____

Drlg. Data Edwards Pool

RUR

J. E. TYRA

