


Section 9 Township 17 Range 8W

Well No. 3 Mølhagen (*Mølhagen*)

Company Continental

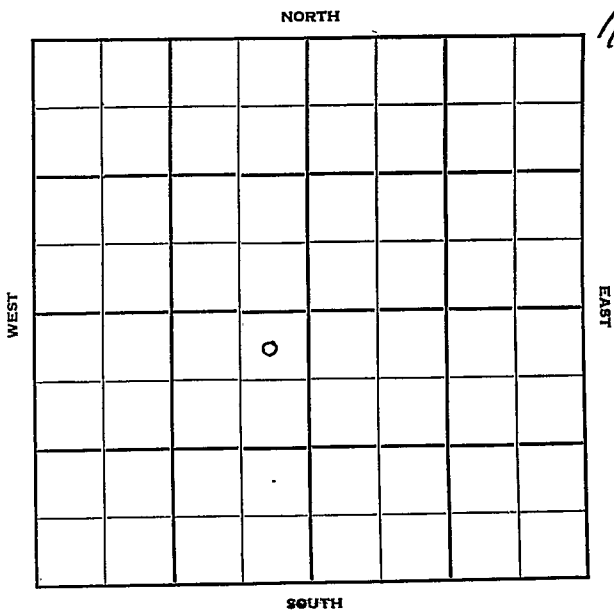

Ellsworth

KANSAS

Sec. 9 Twp. 17 R. 8 W

Well No. # 3 Mollhagen Farm

Continental Company

Contractor

Edwards Pool


330 Ft. from N. Line

Ft. from S. Line

330 Ft. from E. Line

Ft. from W. Line

NE NE SW

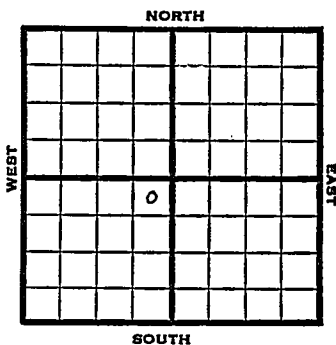

1951 Elev. 1726' REPORT

8/1 Spud 7-31-51
10" @ 310 WOC

8/29 Spud 7-31-51
Oil Well TD 3251
10" @ 310
Heeb. 2638
Br Lime 2758
KC 2775
Arb. 3198
TD 3208
5" @ 3200
CO to 3229
FU 2800' oil 7 hr.
DD 3251 S/20 boph 2 hr.
Comp. 417 bopd

COMPLETED

