


Section 9 Township 17 Range 8W

Well No. #5 Mollhagen

Company Continental Oil

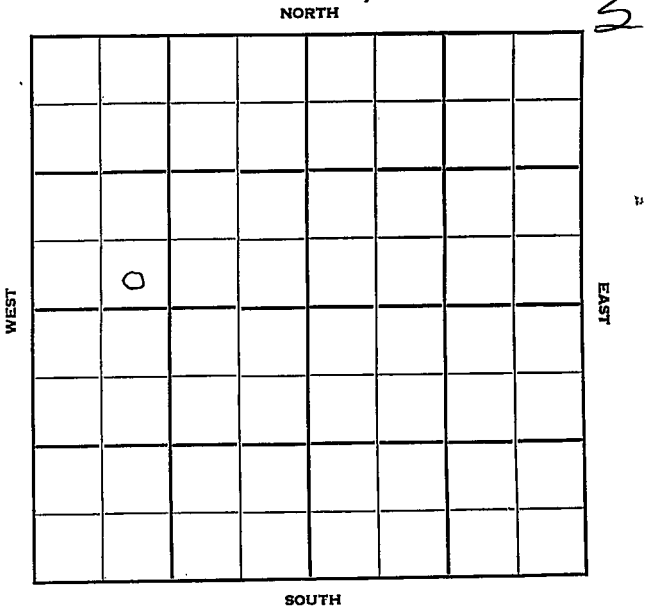

Ellsworth

KANSAS

Sec. 9 Twp. 17 R. 8 W

Well No. # 5 Mollhagen Farm

Continental Oil Company

Lohman & Johnson Contractor
North Edwards Pool


 Ft. from N. Line

330 Ft. from S. Line

 Ft. from E. Line

990 Ft. from W. Line

SE SW NW

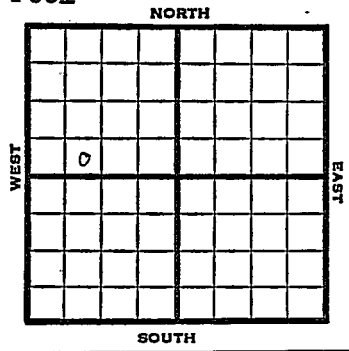

1951 Elev. 1698' REPORT

9/5 Spud 8-26-51
10" @ 323
Arb. 3192-95'
5" @ 3193' WOC

9/26 Spud 8-26-51
Oil Well TD 3218
10" @ 323
Heeb. 2632' Br. lime 2742
Ians. 2761 Cong. 3129 Simp. 3149
Arb. 3192-95
5" @ 3193 TD 3218
S/ 30 boph Comp. 288 bopd

COMPLETED

County Ellsworth State Kansas

Sec. 9 (Blk. 17 (Sur. Rge.) 8W) Map No.

Operator Continental Oil

Well No. 5 Farm Mollhagen

Elev. Location SE SW NW

330 Ft. From S Line NW

990 Ft. From W Line Quarter

1st. Report SEP 5 1951

Completion

Remarks

Lohman & Johnson - Contr.

Spudding Date 8-26-51

Drig. Data North Edwards Pool

10" @ 323 Arb. 3192-95 5" @ 3193 WOG

