


Section 9 Township 17 Range 8 W

Well No. # 6 Mollhagen

Company Continental Oil

NORTH

m

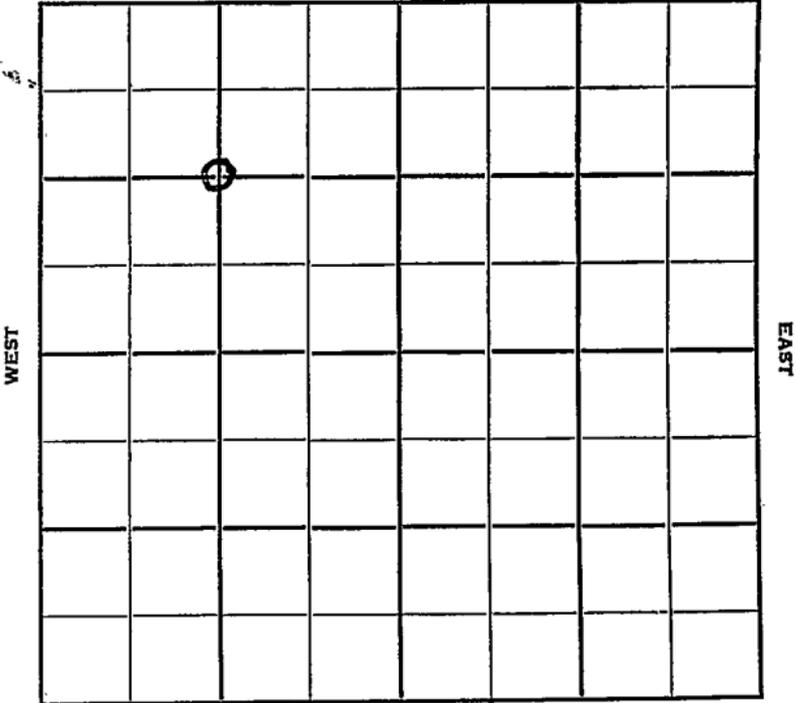

SOUTH



Sec. 9 Twp. 17 R. 8W

Well No. #6 Mollhagen Farm

Continental Oil Company

Contractor


1320' Ft. from N. Line

Ft. from S. Line

Ft. from E. Line

1320' Ft. from W. Line

C NW/4

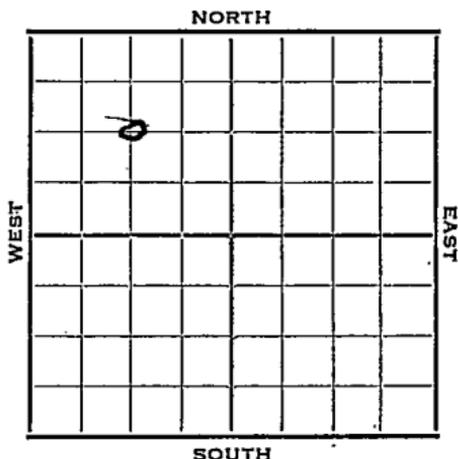

1952 Elev. 1697' REPORT

| | |
|------|---|
| 6/11 | Spud 6-6-52 10" @ 327 Drlg. 2200' |
| 6/18 | Schl Tops: Br Li 2728 Lans. 2745 BKC 3073 Arb. 3167 RTD 3176 5" @ 3170 WOC |
| 6/25 | DP DD 3200 TD @ 3176' Had 2000' oil 14 hrs. S/10 BOPH & trace wtr. |
| 7/2 | NR |
| 7/9 | " |
| 7/17 | " |
| 7/23 | Spud 6-6-52 OilWell TD 3200 10" @ 327 Br Lime 2728 Lans. 2745 BKC 3073 Arb. 3167 TD 3176 5" @ 3170 DD 3200 At 3176 FU 2000' oil 14-hr. S.10 boph Comp 249 bopd |


County **Ellsworth** State **Kansas**

Sec. **9** (Blk. Twp.) **17** (Sur. Rge.) **SW** Map No.

Operator **Continental Oil**

Well No. **6** Farm **Mollhagen**

Elev. Location **C NW/4**

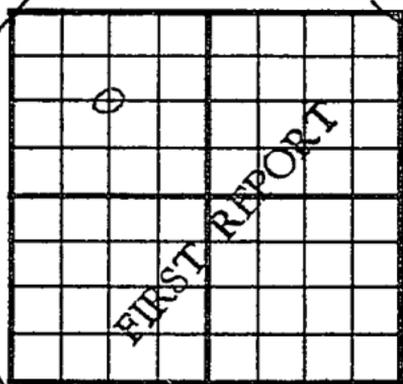

1320 Ft. From **N** Line **NW**
1320 Ft. From **W** Line Quarter

1st. Report **JUN 11 1952**

Completion

Remarks

Spudding Date **6-6-52**

Drlg. Data **N Edwards**

10" @ 327 Drlg. 2200

J. G. McGEHEE


County Ellsworth State Kansas

Sec. 9 (Blk.) 17 (Sur.) 8W Map No.

Operator Continental Oil

Well No. 6 Farm Mollhagen

Elev. 1697 Location C NW/4

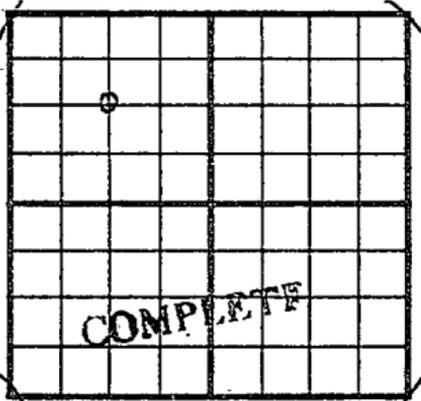

1320Ft. From N Line NW

1320Ft. From W Line Quarter

1st. Report

Completion JUL 23 1952

Remarks N. Edwards Pool

Spudding Date 6-6-52

Drlg. Data Oil well TD 3200

10" @ 327 Br. lime 2728 Lans. 2745

B KC 3073 Arb. 3167 TD 3176

5" @ 3170 DD 3200 At 3176 FU 2000' oil

14 hr. S/ 10 boph

Comp. 249 bopd

J. G. McGEHEE