


Section 9 Township 17 Range 8W

Well No. #1 Shanyo

Company Continental

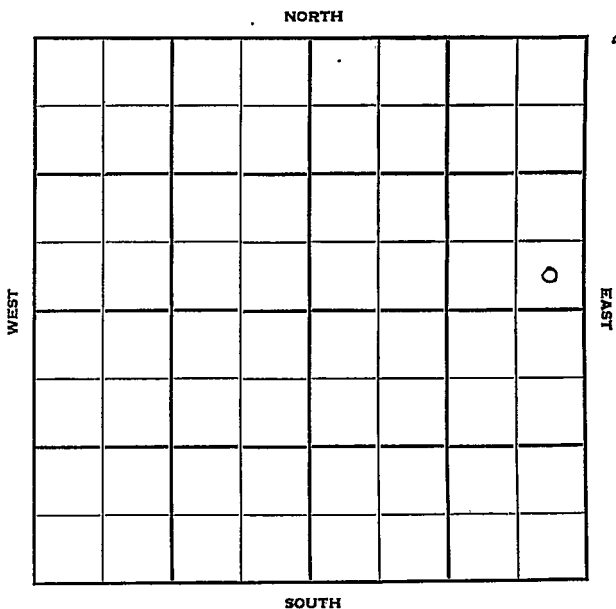

Sec. 9 Twp. 17 R. 8 W ✓

Well No. # 1 Shanyo Farm

Continental Company

Contractor

North Edwards Pool

Ft. from N. Line


NORTH

330' Ft. from S. Line

330 Ft. from E. Line

Ft. from W. Line

SE SE NE

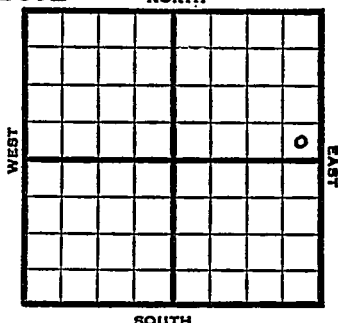

1951

Elev. 1653'

REPORT

3/14

Location

6/20

Spud 3-18-51

Oil Well TD 3204

10" @ 300

Heeb. 2555 Br Lime 2672

Lans. 2692 Cong. 3055

Viola 3083 Simp 3124

Arb. 3178

DST 3179-84 opn 1 hr

Rec. 1750' gassy oil 60' hoem

DST 3184-89 opn 15 min.

Rec. 418' live oil

DST 3189-94 opn 15 min Rec.

520' free oil

DST 3194-99 opn 10 min

Rec. 410 wtr TD 3204


5" @ 3203 11/3160-64 10/3144-48

B/21 gsw 7 hr SP 3140

46/3122-38 S/1 3/4 boph 1000 A

S/8 boph Comp. 83 bopd

~~COMPLETED~~

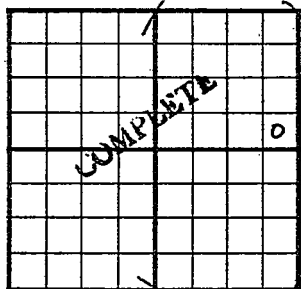County Ellsworth State KansasSec. 9 (Blk.
Twp.) .17 (Sur.
Rge.) 8W Map No.Operator ContinentalWell No. 1 Farm ShanyoElev. 1653 Location SE SE NE330 Ft. From S Line NE330 Ft. From E Line Quarter

1st. Report

Completion JUN 20 1951Remarks North Edwards PoolSpudding Date 3-18-51Drlg. Data Oil well TD 320410" @ 300 Heeb. 2555 Br. lime 2672Lans. 2692 Cong. 3055 Viola 3083Simp. 3124 Arb. 3178 DST 3179-84open 1 hr. Rec. 1780' gassy oil 60' hoemDST 3184-89 open 15 min. Rec. 418' liveoil DST 3189-94 open 15 min. Rec.520' free oil DST 3194-99 open 10 min.Rec. 410' water TD 3204 5" @ 320311/ 3160-64 10/ 3144-48 B/ 21' gsw 7 hr.SP 3140 46/ 3122-38 S/ 1 3/4 boph1000 A S/ 8 boph Comp. 83 bopd.

J. E. TYRA