


Section 9 Township 17 Range 8 W

Well No. # 4 Shonyo

Company Continental

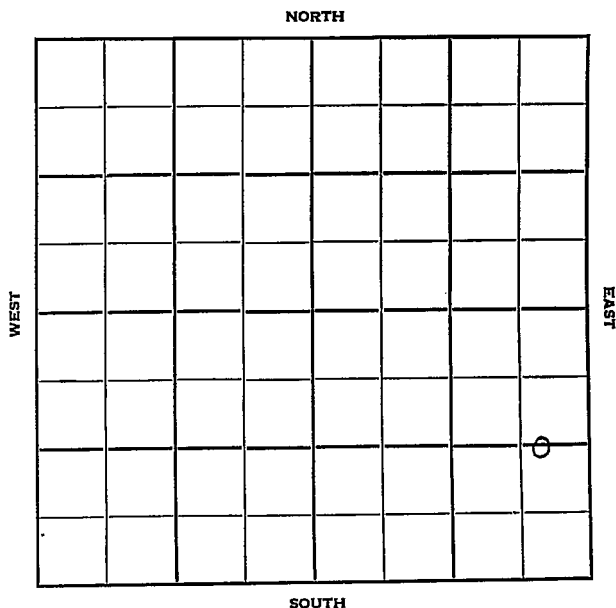

Ellsworth

KANSAS

Sec. 9 Twp. 17 R. 8 W. ✓

Well No. # 4 Shonyo Farm

Continental Company

Edwards Pool Contractor


Ft. from N. Line

1320 Ft. from S. Line

1440 Ft. from E. Line

Ft. from W. Line

C E L E₂¹ SE

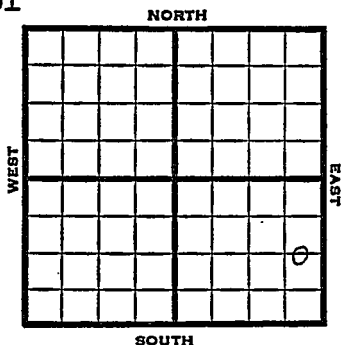

1951

Elev. 1660' REPORT

4/25

M I R

5/16

Spud 4-24-51

Oil well TD 3190'

10" @ 306' Heeb 2566' Br. line 2685'

Simp. 3125' Arb. 3161'

TD 3190' 5" @ 3163' S/246 BO

6 hr.

Comp. 3000 BOPD

COMPLETED

Sec. 9 (Blk. Twp.) 17 (Sur. Rge.) SW Map No.

Well No. 4 Farm Shonyo

Elev.	Location	C E L E ¹ / ₂ SE
-------	----------	--

1320 Ft. From S Line SE

440 Ft. From E Line Quarter

1st. Report APR 25 1951

Completion


Remarks

Spudding Date _____

Drig. Data Edwards Pool

M I R

J. E. TYRA

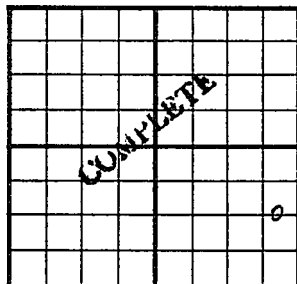County Ellsworth State KansasSec. 9 (Blk.
Twp.) 17 (Sur.
Rge.) 8W Map No.Operator ContinentalWell No. 4 Farm ShonyoElev. 1660 Location C E L E $\frac{1}{2}$ SE1320 Ft. From S Line SE440 Ft. From E Line Quarter

1st. Report

Completion MAY 16 1951Remarks Edwards PoolSpudding Date 4-24-51Drlg. Data Oil well TD 319010" @ 306 Heeb. 2566 Br. lime 2685Simp. 3125 Arb. 3161 TD 3190 5" @ 3163S/ 246 bo 6 hr. Comp. 3000 bopd

J. E. TYRA