


Section 9 Township 17 Range 8W

Well No. #6 Shonyo

Company Continental Oil

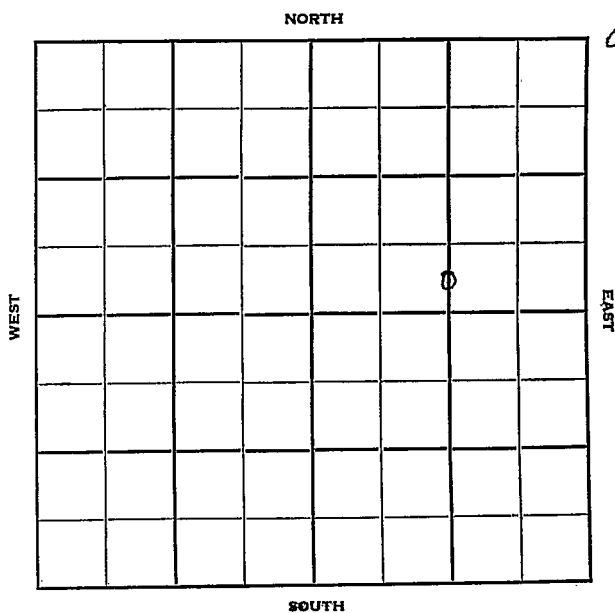

Ellsworth

Sec. 9 Twp. 17 R. 8W ✓

Well No. #6 Shonyo Farm _____

Continental Oil Company _____

Edwards Pool Contractor _____


Ft. from N. Line _____

440' Ft. from S. Line _____

1320' Ft. from E. Line _____

Ft. from W. Line _____

C S L S $\frac{1}{2}$ NE

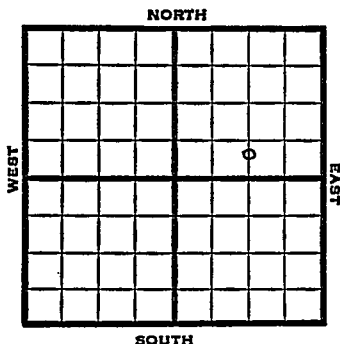

1951 Elev. 1676' REPORT

5/9 Spud 5-6-51
10" @ 310'
6/5 Spud 5-6-51
Oil Well TD 3210
10" @ 310
Heeb. 2580 Br Lime 2699
DST 3173-79 opn 75 min. Rec. 4' mud
DST 3176-98 opn 1 hr. Rec. 5' mud
Arb. 3205
DST 3201-06 opn 1 hr
Rec. 170' oil 120' hoam
DST 3206-10 opn 15 min.
Rec. 450' free oil TD 3210
5" @ 3206 FU 3050 oil 4 hr.
Comp. 611 bopd

COMPLETED

County **Ellsworth** State **Kansas**

Sec. **9** (Blk. **17** (Sur. **8W** Map No. (Twp.) (Rge.)

Operator **Continental Oil**

Well No. **6** Farm **Shonyo**

Elev. Location **C S L S $\frac{1}{2}$ NE**

| | | | | | |
|--|--|--|--|--|--|
| | | | | | |
| | | | | | |
440 Ft. From **S** Line **NE**

1320 Ft. From **E** Line **Quarter**

Ist. Report **MAY 9 1951**

Completion

Remarks

Spudding Date **5-6-51**

Drlg. Data **Edwards Pool**

10" @ 310

County Ellsworth State KansasSec. 9 (Blk.) 17 (Sur.) 8W Map No.Operator Continental OilWell No. 6 Farm ShonyoElev. 1676 Location C S L S $\frac{1}{2}$ NE

| | | | | | |
|--|--|--|--|--|--|
| | | | | | |
| | | | | | |
440 Ft. From S Line NE1320 Ft. From E Line Quarter

Ist. Report

Completion JUN 6 1951Remarks Edwards PoolSpudding Date 5-6-51Drlg. Data Oil well TD 321010" @ 310 Heeb. 2580 Br. lime 2699DST 3173-79 open 75 min. Rec. 4' mudDST 3176-98 open 1 hr. Rec. 5' mudArb. 3205 DST 3201-06 open 1 hr.Rec. 170' oil 120' hoom DST 3206-10open 15 min. Rec. 450' free oil TD 32105" @ 3206 FU 3050' oil 4 hr.Comp. 611 bopd

J. E. TYRA