

Section 9 Township 17 Range 8 WWell No. # 10 ShonyoCompany Continental Oil

NORTH

10

WEST

				0			

EAST

SOUTH

Sec. 9 Twp. 17 R. 1 8W

Well No. #10 Shanyo Farm

Continental Oil Company

Edward Pool Contractor


440' Ft. from N. Line

Ft. from S. Line

Ft. from E. Line

440' Ft. from W. Line

NW NW SE

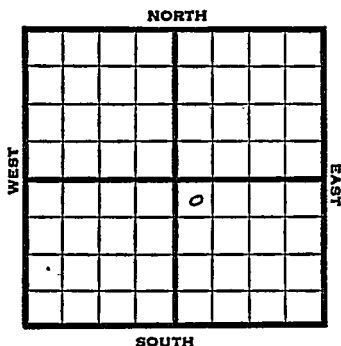

1951

Elev. 1692' REPORT

7/11


Spud 7-7-51
10" @ 312
Drlg. 1482'

8/1

Spud 7-7-51
Oil well TD 3222' 10" @ 312
Heeb 2590' Br. lime 2712' Lans 2728'
Arb. 3086' 5" @ 3100 TD 3222'
S/17 BOPH
Comp. 393 BOPD

COMPLETED

County **Ellsworth** State **Kansas**
 Sec. **9** (Blk.) **17** (Sur.) **SW** Map No.
 Operator **Continental Oil**
 Well No. **10** Farm **Shonye**
 Elev. Location **NW NW SE**

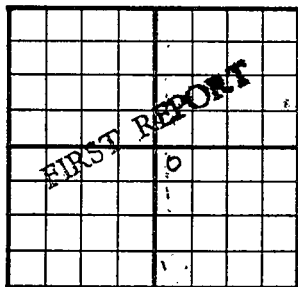

440 Ft. From **N** Line **SE**
440 Ft. From **W** Line **Quarter**

Ist. Report **JUL 11 1951**

Completion

Remarks


Spudding Date **7-7-51**

Drlg. Data **Edward - pool**

10" @ 312 + Drlg. 1482

J. E. TYRA

County Ellsworth State Kansas
 Sec. 9 (Blk.) 17 (Sur.) 8W Map No.
 Operator Continental Oil
 Well No. 10 Farm Shonyo
 Elev. 1692 Location NW NW SE

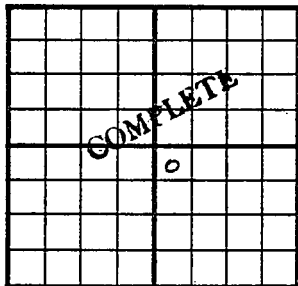

440 Ft. From N Line SE
440 Ft. From W Line Quarter

1st. Report

Completion AUG 1 1951

Remarks Edwards Pool

Spudding Date 7-7-51

Drilg. Data Oil well TD 3222

10" @ 312 Heeb. 2590 Br. lime 2712

Lans. 2728 Arb. 3086 5" @ 3100

TD 3222 S/ 17 boph Comp. 393 bopd

J. E. TYRA