


Section 9 Township 17 Range 8W

Well No. 12 Shenye (Shonyo)

Company Continental Oil

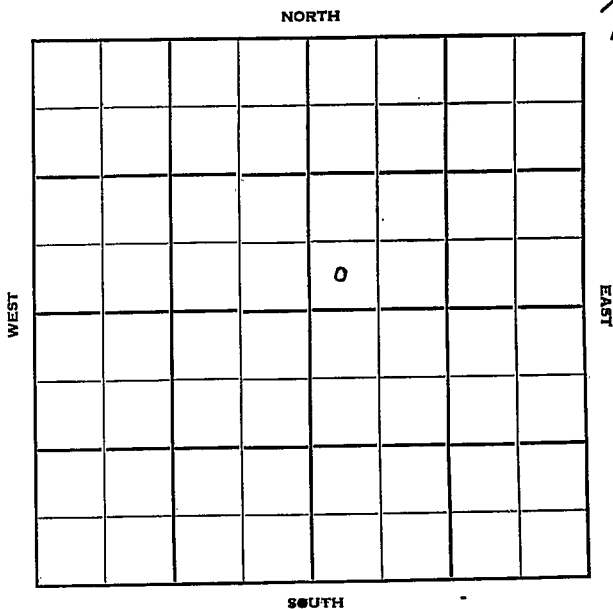

Ellsworth

KANSAS

Sec. 9 Twp. 17 R. 8 W

Well No. # 12 Shonyo Farm \_\_\_\_\_

Continental Oil Company \_\_\_\_\_

Edwards Pool Contractor \_\_\_\_\_


\_\_\_\_\_ Ft. from N. Line

330 Ft. from S. Line

\_\_\_\_\_ Ft. from E. Line

330 Ft. from W. Line

SW SW NE

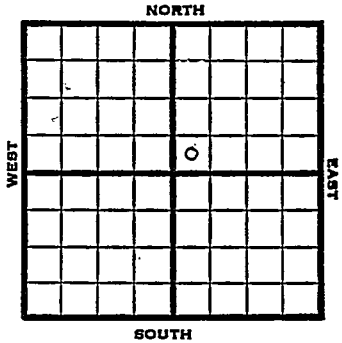

1951 Elev. 1719' REPORT

7/25

Spud 7-19-51  
10" @ 305'  
Drlg. 1802'

8/15

Spud 7-19-51  
Oil well TD 3249' 10" @ 305'  
Heeb 2632' Br. lime 2754' Lans 2772'  
Cong. 3112' Simp. 3127' Arb. 3185'  
TD 3190' 5" @ 3186 DD 3193'  
FU 150' oil 1 hr. 1800' oil 18 hr.  
DD 3249' S/26 BOPH  
Comp. 397 BOPD

**COMPLETED**



