


Section 9 Township 17 Range 8W

Well No. #13 Shonyo

Company Continental Oil

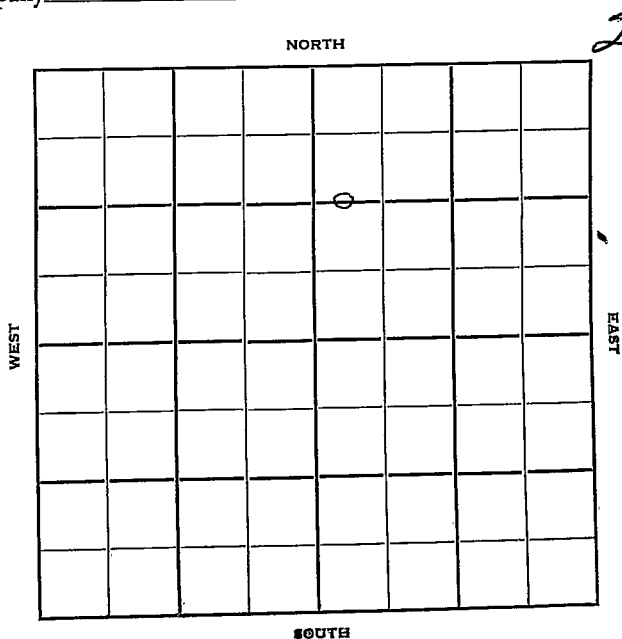

Ellsworth

KANSAS

Sec. 9 Twp. 17 R. 8 W

Well No. # 13 Shonyo Farm

Continental Oil Company

Contractor

Edwards Pool


1320 Ft. from N. Line

Ft. from S. Line

Ft. from E. Line

330 Ft. from W. Line

C $W\frac{1}{2}$ $W\frac{1}{2}$ NE

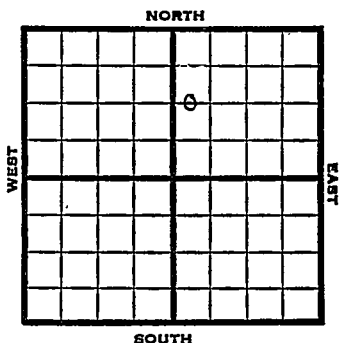

1951

Elev. 1679' REPORT

8/8


Spud 8-2-51
10" @ 309
Drilg. 2405'

8/15

Spud 8-2-51
D & A TD 3320' 10" @ 309'
Heeb 2601' Br. lime 2724'
KC 2744' Simp. 3220' Arb. 3269'
TD 3320' D & A

ABANDONED

J. E. TYRA

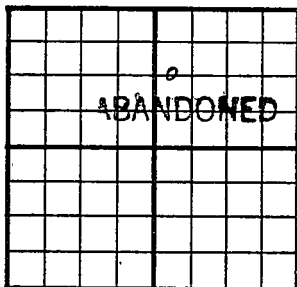County Ellsworth State KansasSec. 9 (Blk.
Twp.) 17 (Sur.
Rge.) 8W Map No.Operator Continental OilWell No. 13 Farm ShonyoElev. 1679 Location C W $\frac{1}{2}$ W $\frac{1}{2}$ NE1320 Ft. From N Line NE330 Ft. From W Line Quarter1st. ReportCompletion AUG 15 1951Remarks Edwards PoolSpudding Date 8-2-51Drlg. Data D & A TD 332010" @ 309 Heeb. 2601 Br. lime 2724KC 2744 Simp. 3220 Arb. 3269 TD 3320D & A

J. E. TYRA