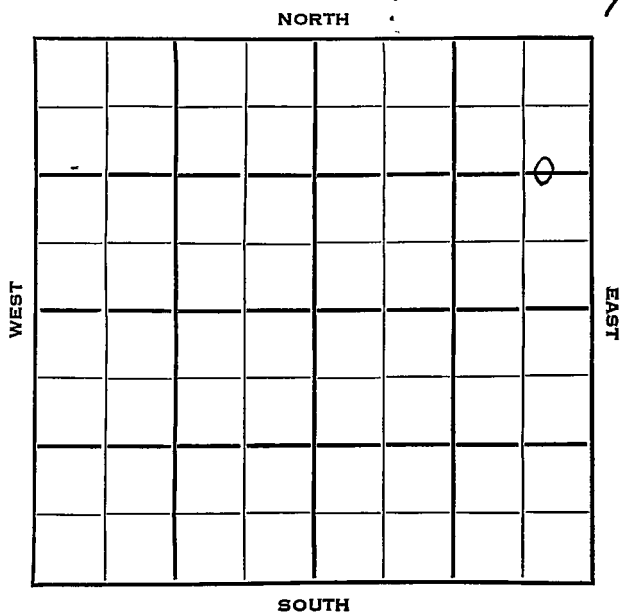


Section 9 Township 17 Range 8 WWell No. # 111 ShonyoCompany Continental Oil

Ellsworth KANSAS

SEC.	9	TWP.	17	R.	8 W	✓
------	---	------	----	----	-----	---

WELL NO. # 14 Shonyo FARM

COMPANY Continental Oil

CONTRACTOR Anschutz


N. Edwards Pool

1320 Ft. from N. Line

Ft. from S. Line

1440 Ft. from E. Line

Ft. from W. Line

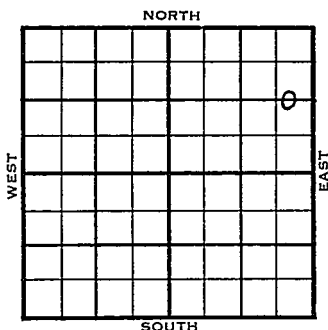

C E $\frac{1}{2}$ E $\frac{1}{2}$ NE

	ELEVATION	REPORT
1954	1647'	
2/3	Spud 2-2-54	
	Drlg. 140'	
2/10	8" @ 323 w/175	
	Drlg. 2920'	
2/17	Heeb 2552', Br li 2673', Lans 2693',	
	B KC 3010', Arb. 3192'	
	DST 3188-95', 1 hr., 2340' SW, 1070#	
	RTD 3210'	
	5" @ 3203'	
2/24	CO 3177', 12/3170-74, trace wtr.	
	57/3139-58', S/26 BO + trace wtr 12 hr	
	sd-o-frac, S 120 BO 8 hrs.	
3/3	P/180 BO 36 hrs.	
3/10	Spud 2-2-54 Oil well TD 3210	
	8" @ 323 Heeb 2552 Br. lime 2673	
	Lans. 2693 B KC 3010 Arb. 3192	
	DST 3188-95 open 1 hr rec 2340' SW	
	1070# TD 3210 5" @ 3203 CO to 3177	
	12/3170-74 B/wtr. 57/3139-58	
	S/26 BO 12 hr. sd-oil-frac S/120 BO	
	8 hr. P/180 BO 36 hr.	
	Comp. 179 BOPD 1 BW	

COMPLETED

County **Ellsworth** State **Kansas**

Sec. 9 (Blk. Twp.) 17 (Sur. Rge.) SW Map No.

Operator Continental Oil

Well No. 14 Farm Shono

Elev. 1647 Location C $E\frac{1}{2}$ $E\frac{1}{2}$ NE

FIRST REPORT

1520 Ft. From N Line NE

440 Ft. From E. Line. Quarter

1st. Report FEB 3 1954

Completion

Remarks

Anschutz - Contr.

Spudding Date **2-2-54**

Dflg. Data N. Edwards Pool


dr 1g. 140

County Ellsworth State Kansas

Sec. 9 (Blk.) 17 (Sur.) 8W Map No.

Operator Continental Oil

Well No. 14 Farm Shonyo

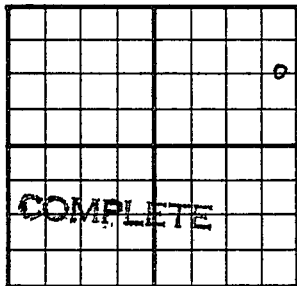Elev. 1647 Location C E $\frac{1}{2}$ E $\frac{1}{2}$ NE

1320 Ft. From N Line NE

440 Ft. From E Line Quarter

1st. Report

Completion MAR 10 1954

Remarks N. Edwards Pool

Anschutz - Contr.

Spudding Date 2-2-54

Drig. Data Oil well TD 3210

8" @ 323 Heeb. 2552 Br. lime 2673

Lans. 2693 B KC 3010 Arb. 3192

DST 3188-95 open 1 hr. Rec. 2340' sw

1070# TD 3210 5" @ 3203 CO to 3177

12/ 3170-74 B/ wtr. 57/ 3139-58

S/ 26 bo 12 hr. sd-oil-frac S/ 120 bo

8 hr. P/ 180 bo 36 hr.

Comp. 179 bopd 1 bw