


Section 9 Township 17 Range 8 W

Well No. # 9 Shonyo

Company Continental Oil

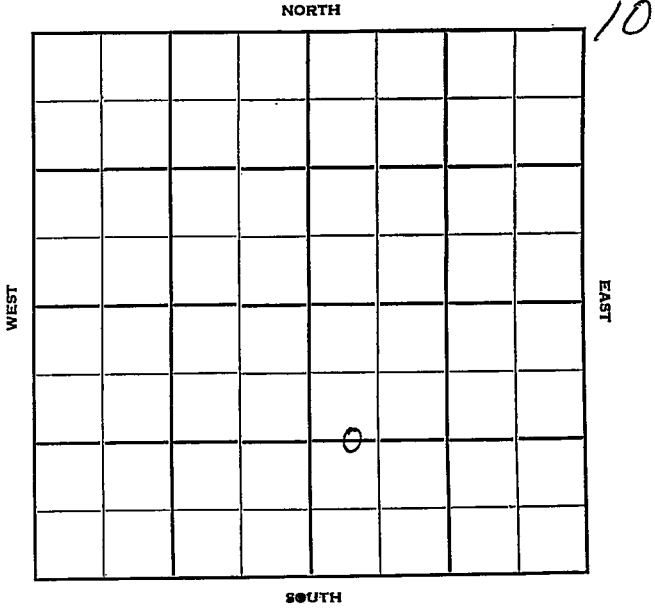

Sec. 9 Twp. 17 R. 8 W

Well No. # 9 Shonyo Farm

Continental Oil Company

Contractor

**Edwards Pool**


Ft. from N. Line

1320 Ft. from S. Line

Ft. from E. Line

440 Ft. from W. Line

W/2 W/2 SE

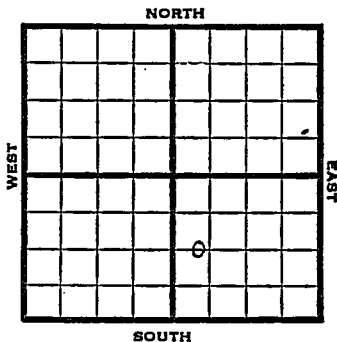

1951

Elev. 1708' REPORT

6/27

Spud 6-26-51  
Drlg. 40'

6/29

Spud 6-26-51  
Oil Well TD 3138  
10" @ 316  
Heeb. 2599  
Br Line 2719  
Lans. 2736  
Arb. 3097  
TD 3110  
5" @ 3100  
FU 2800' oil 3 hr. DD 3138  
S/48 boph 3 hr. Comp. 3000 bopd

**COMPLETED**

County Ellsworth State Kansas

Sec. 9 (Blk. 17) (Sur. 8W) (Twp.) (Rge.) Map No.

Operator Continental Oil

Well No. 9 Farm Shonyo

Elev. Location W/2 W/2 SE

FIRST REPORT									

1320 Ft. From S Line SE

440 Ft. From W Line Quarter

1st. Report JUN 27 1951

Completion \_\_\_\_\_

Remarks \_\_\_\_\_

Spudding Date 6-26-51

Drlg. Data Edwards Pool

~~Drlg. 40~~

