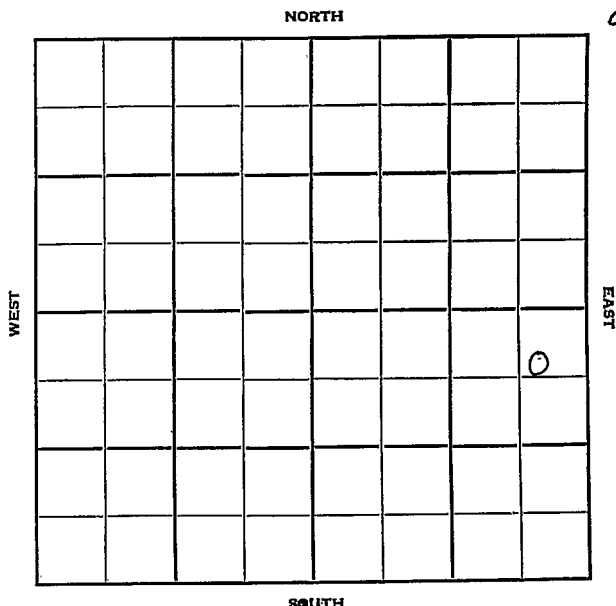


O.W.W.O.

Section 9 Township 17 Range 8 WWell No. # 3 ShonyoCompany Continental Oil

O.W.W.O.

Ellsworth

KANSAS

Sec. 9 Twp. 17 R. 8W

Well No. #3 Shonyo Farm

Continental Oil Company

Contractor


440' Ft. from N. Line

_____ Ft. from S. Line

440' Ft. from E. Line

_____ Ft. from W. Line

NE NE SE

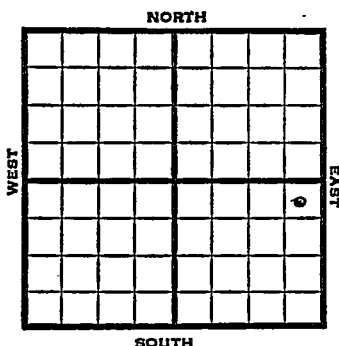

1951 Elev. 1656' REPORT

4/18 Spud 4-13-51
10" @ 308'
Drlg. 2307'

8/1 Spud 4-13-51
Oil well TD 3207' 10" @ 308'
Lans. 2694' Viola 3081' Heeb 2555'
Br. lime 2674' Simp. 3118'
Arb. 3166'
TD 3207' 7" @ 3206' DC to 3195'
104/3166-92 FU 3000' oil 10 hr.
S/47 BOPH
Comp. 2440 BOPD 13% W

COMPLETED

1956

O.W.W.O.
W.O.

7-25 OLD INFO: OTD 3207; 7" @ 3166; Was Arb. Prod.

NEW INFO; 2 1/2" tbg to 3163';
Sqz. Arb. perfs, 3166-76 w/100
PB 3150; 24/ 3132-38; recover plug
re-set @ 3128; 28/3119-26;
Pkr, @ 3086; Sd-Oil-Frac. pulled tbg
& pkr; DP to 3163; P/1 b after ld.
P/30 bo / 1 bw 16 hrs, Grav 37
P/ 38 bopd / 2 bwpd from Simp. sd. 3119-
(OVER)

1956

7-25, continued

26- & 3132-38- $1\frac{1}{2}$ " chk.

(Allow 25 boph)

Comp.

L. 2694'; V. 3081'; S. 3118';

A. 3166';

FIRST REPORT



COMPLETED

County Ellsworth State KansasSec. 9 (Blk.) 17 (Sur.) 8W Map No.Operator Continental OilWell No. 3 Farm ShonyoElev. Location NE NE SE

440 Ft. From N Line SE440 Ft. From E Line Quarter1st. Report APR 18 1951

Completion

Remarks

Spudding Date 4-13-51

Drig. Data

10" @ 308 drlg. 2307

J. E. TYRA

J. E. TYRA

OW 40

County Ellsworth Elev. 1659
 Sec. 9 Twp. 17S Rge. 8W
 Company Continental Oil Co.
 Farm Name Shonyo No. 3

TOPS	DEPTH	LOG	DATUM	Loc. in Sec.
Anh.				2220' fsl
Tr.				440' fsl SE/4
H.				SE NE SE
Tr.				
Dg.				
Bl.	2694			Geol.
L.				Contr.
K.C.				
B.K.C.				
Ce.				
C.				
M.				
M.				Pool
K.				
Mz.				
Ma.				
V.	3081			
S.	3140			
S.	3166			
A.				
R.				
PE.				
G.				
T.D.				

JUL 25 1956
 FIRST REPORT
 COMPLETE

Date Comm.

Old info: OTD 3207 7" 3166 - was Arb
 Prod.

New info: 2 1/2" tbg. to 3163'; Sqz. Arb.
 perfs, 3166-76 w/100 PB 3150; 24/3232-38
 recover plug re-set @ 3128; 28/3119-26;
 pkr. @ 3086; Sd-Oil-Frac. pulled tbg. &
 pkr DP to 3163; T & R - pump lb after
 ld. P 30 bo. / 1 bw 16 hrs. - grav 37°;

P 38 bopd / 2 bwpd from Simp sd. 3119-
26 & 3132-38 - 1 $\frac{1}{2}$ " Chk. (Allow 25 boph)
Comp.