


Section 18 Township 18 Range 10 W

Well No. # 1 Hertach

Company K & E Drlg.

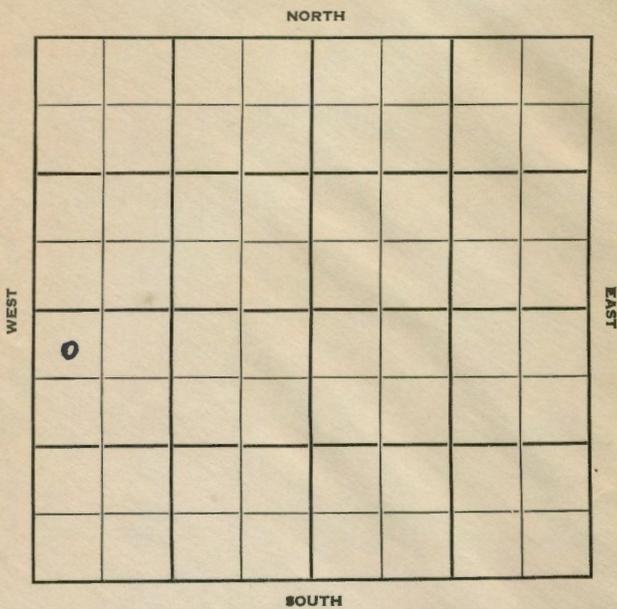

Sec. 18 Twp. 18 R. 10W

Well No. #1 Hertach Farm

K & E Drlg. Company

Contractor


330 Ft. from N. Line

Ft. from S. Line

Ft. from E. Line

330 Ft. from W. Line

NW NW SW

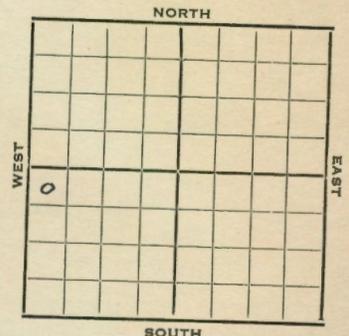

1952

Elev. 1773' REPORT

5/21
5/28

Location
8" @ 201'
Anhy 557' Drlg. 2667'

6/4

Spud 5-21-52
D&A TD 3318
8" @ 201'
Anhy 557 Heeb. 2871
Br Lime 2984 Lans. 3000
Arb. 3305
DST 3310-18 opn 1/4 hr. Rec. 367' fluid
95% wtr TD 3318 D&A

ABANDONED

