


KANSAS

Rice

Section 18 Township 18 Range 10W

Well No. 1 Hertch

Company Eldorado
Orth

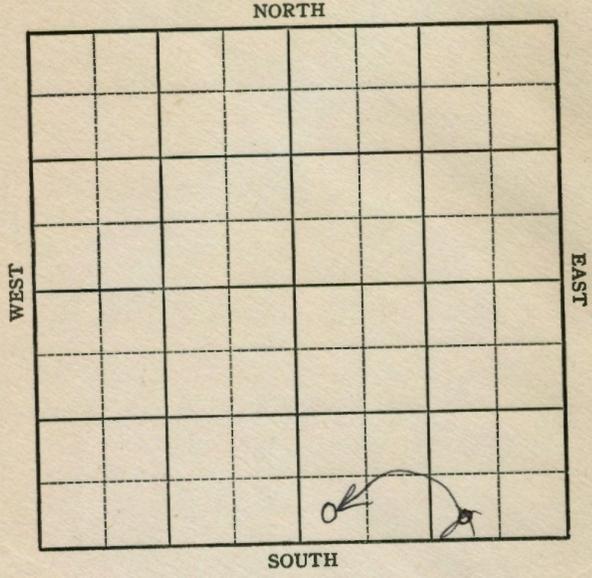

Rice **KANSAS**

10W

Sec. 18 Twp. 18 R. 10W

Well No. #1 Hertch Farm _____

Eldorado Company
Orth Pool

_____ Ft. from N. Line


330' Ft. from S. Line

~~000'~~ Ft. from E. Line

_____ Ft. from W. Line

330 Ft. from W. Line

~~SW SE SE~~
SW SE

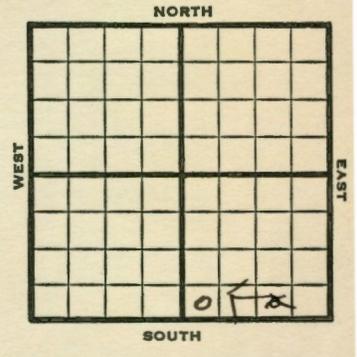

1949 **Elev 1768'** REPORT

- 5/25 8" @ 250'
- 6/1 **Lans 2982'**
Drlg 3013'
- 6/8 **Lans 2982'**
Arb. 3320'
TD 3333'
Aband.

ABANDONED

Map No. _____ Sec. 18 Twp. 18 R. 10W

Well No. 1 Hertch

Eldorado Company

Contractor

SW SE SE

FIRST REPORT
SECTION PLAT

_____ Ft. from N. Line

330 Ft. from S. Line

990 Ft. from E. Line

_____ Ft. from W. Line

Rice County

Location _____

Rig up _____

Drilling and Remarks:

8" @ 250

RECORD

Cased _____ in., _____ ft.

Sand _____

Gas _____

Oil _____

Total Depth _____

PRODUCTION

1st 24 hrs. Nat. _____

1st 24 hrs. after shot _____

Gas _____ Cu. Ft.

Dry Hole _____

Abandoned _____

Date

MAY 25 1949

19

S. J. LEWIS

Scout