


KANSAS

Rice

Section 18 Township 18 Range 10W  
Well No. #1 Popplereiter  
Company Inland Oil

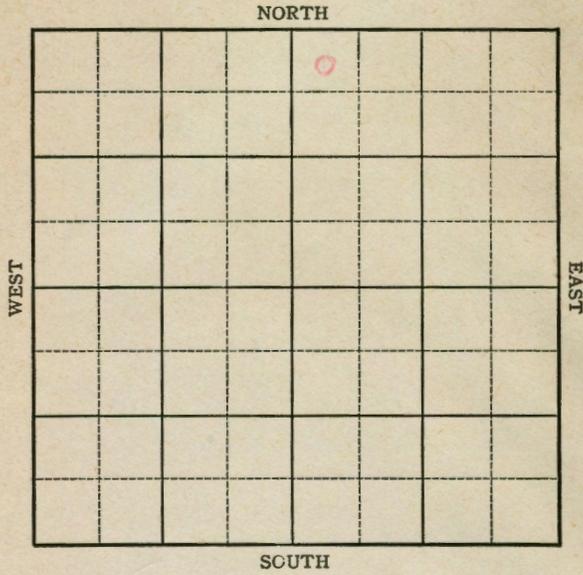


KANSAS

Rice County

Sec. 18 Twp. 18 R. 10W  
Well No. #1 Poppelreiter Farm \_\_\_\_\_  
Inland Oil Company \_\_\_\_\_

Wildcat

330 Ft. from N. Line  
\_\_\_\_\_ Ft. from S. Line  
330 Ft. from E. Line  
330 Ft. from W. Line

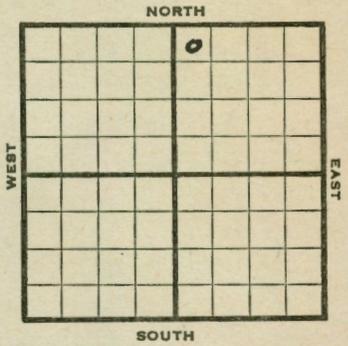

NW NE

1945


R E P O R T

2/28	Location
3/7	"
3/14	R U R
3/23	8" @ 227 Drlg. 1330'
3/29	Topeka 2590 Drlg. 2795
4/4	Lans 2983 Cong 3259 Arb 3312 TD 3342

ABANDONED

Pool Name Wildcat  
 Map No. 155 Sec. 18 Twp. 18 R. 10W  
 Well No. 1 Poppelreiter  
Inland Oil Company  
ABANDONED Contractor

NW NE  
330 Ft. from N. Line  
 Ft. from S. Line  
 Ft. from E. Line  
330 Ft. from W. Line

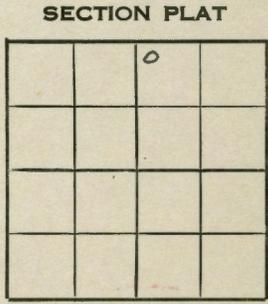

Rice County

Location \_\_\_\_\_  
 Rig up \_\_\_\_\_  
 Drilling and Remarks:  
*Land 2983*  
*Con 98259*  
*Ar 43312*


RECORD  
 Cased \_\_\_\_\_ in., \_\_\_\_\_ ft.  
 Sand \_\_\_\_\_  
 Gas \_\_\_\_\_  
 Oil \_\_\_\_\_  
 Total Depth 2842

PRODUCTION  
 1st 24 hrs. Nat. \_\_\_\_\_  
 1st 24 hrs. after shot \_\_\_\_\_  
 Gas \_\_\_\_\_ Cu. Ft.  
 Dry Hole \_\_\_\_\_  
 Abandoned \_\_\_\_\_

Date APR 4 1945 19 S. J. LEWIS Scout

FORM 56 200 BKS. 1-44 PETROL Pool Name Wildcat  
 Map No. 55 Sec. 18 Twp. 18 R. 10W  
 Well No. 1 Poppelreiter  
Inland Oil Company  
FIRST REPORT Contractor

NW NE  
330 Ft. from N. Line  
 Ft. from S. Line  
 Ft. from E. Line  
330 Ft. from W. Line

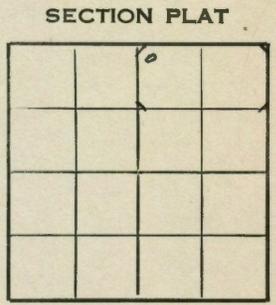

Rice County

Location X \_\_\_\_\_  
 Rig up \_\_\_\_\_  
 Drilling and Remarks:

*Hot File*

RECORD  
 Cased \_\_\_\_\_ in., \_\_\_\_\_ ft.  
 Sand \_\_\_\_\_  
 Gas \_\_\_\_\_  
 Oil \_\_\_\_\_  
 Total Depth \_\_\_\_\_

PRODUCTION  
 1st 24 hrs. Nat. \_\_\_\_\_  
 1st 24 hrs. after shot \_\_\_\_\_  
 Gas \_\_\_\_\_ Cu. Ft.  
 Dry Hole \_\_\_\_\_  
 Abandoned \_\_\_\_\_

Date FEB 28 1945 19 S. J. LEWIS Scout