


Section 18 Township 18 Range 10WWell No. #1 Poppelreiter "B"Company Tom Allan

NORTH

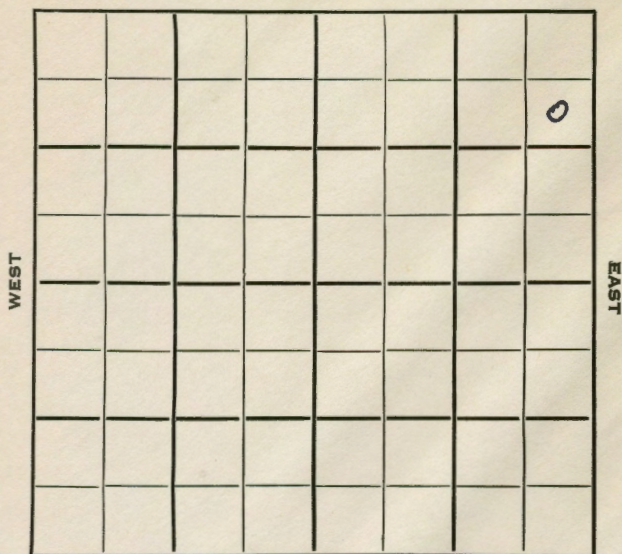

SOUTH

Sec. 18 Twp. 18 R. 10WWell No. #1 Poppelreiter "B" Farm

Tom Allan Company

Tom Allan Contractor

Roesler Pool

990 Ft. from N. Line


Ft. from S. Line

330 Ft. from E. Line

Ft. from W. Line

SE NE NE
Skelly Farmout

NORTH

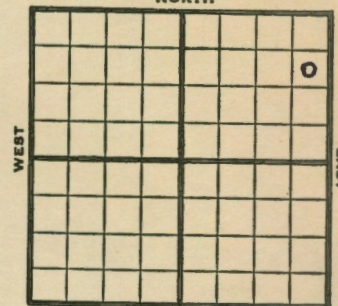

SOUTH

1953 Elev. 1765

REPORT

7/29 Spud 7-23-53
8" @ 254'
Drlg. 2183'8/5 Spud 7-23-53
D & A
TD 3397'
8" @ 254'Anhy 538, Heeb 2848, Br. Lime 2962,
Lans 2979

DST 3055-69 opn 1 hr, rec 45' swcm

905# Penn. Cong 3281, Cong 3350

TD 3397'

D & A

ABANDONED

County Rice State Kansas
Sec. 18 (Blk. Twp.) 18 (Sur. Rge.) 10W Map No.
Operator Tom Allan
Well No. 1 Farm Poppelreiter "B"
Elev. 1765 Location SE NE NE

[illegible]

1st. Report

Completion AUG 5 1953

Remarks	Roesler Pool
---------	--------------

Tom Allan - Contr.

Spudding Date 7-23-53

Drig. Data D & A TD 3397

8" @ 254 Anhy 538 Heeb. 2848

Br. lime 2962 Lans. 2979 DST 3055-69

open 1 hr. Rec. 45' swcm 905#

Penn. Cong. 3281 Cong. 3350 TD 3397

D 2 A

J. G. McGEHEE

County	Rice		State	Kansas
Sec.	18 (Blk. Twp.)	18 (Sur. Rge.)	10W	Map No.
Operator	Tom Allen			
Well No.	1	Farm	Poppelreiter "B"	
Elev.	1765	Location	SE NE NE	

[illegible]

1st. Report JUL 20 1953

Completion

Remarks	Skelly farmout
---------	----------------

Tom Allan - Contr.

Spudding Date 7-23-53

Drig. Data

Roesler Pool

8" @ 254 drlg. 2183

J. G. McGEHEE