

O.W.W.O.

FORM 51 25M 3-49 PETROL

KANSAS

Rice

Section 18 Township 18 Range 10W

Well No. #1 W. Poppelreiter

Company Tom Allen & Hall et al

FORM 2553

O.W.W.O.

Rice

KANSAS

Sec. 18 Twp. 18 R. 10 W

Well No. #1 W. Poppelreiter Farm

Tom Allen & Hall et al Company

Contractor

Wilcoat Roesler


Ft. from N. Line

990 Ft. from S. Line


330 Ft. from E. Line

Ft. from W. Line

NE SE NE

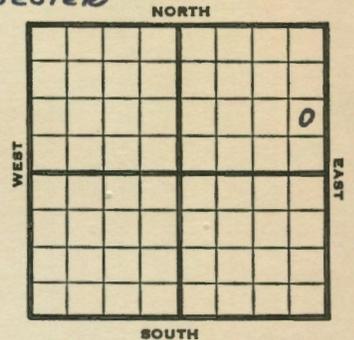

NORTH

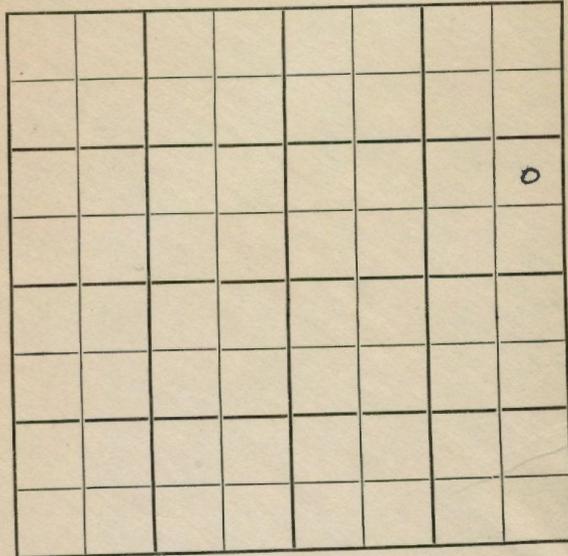

SOUTH

1953

Elev. 1758'

REPORT

3/18

Location

3/26

MI

4/2

8" @ 203

Drig. 2460'

4/9

Heeb 2839 Br 11 2951 Lans 2966

DST 3044-58, 40 mins, 165' 0 & GCM 520#

DST 3117-35 1/2', 1/2 hr, 6' M

Arb. 3268' RTD 3272 5" @ 3272

4/16

DD 3280 1/2 TD 2 BOPH 3000A

S/4 BOPH 2 hrs., POP

4/23

NR

4/30

NR

5/7

P/65 Bopd / 5%

5/13

Spud 3-25-53

Oil Well

TD 3280'

8" @ 203'

Heeb 2839, Br. Lime 2951, Lans 2966,

DST 3044-58 opn 40 min. rec 165' o & gcm 520#

DST 3117-35 opn 1/2 hr, rec 6' mud

Arb 3268

TD 3272'

OVER

1953

Information brought forward.

5/13 5" @ 3272'
DD 3280
2 boph 300 A S/ 4 boph 2 hr.
P/ 65 bopd
Comp. 31 bopd 20% wtr.

COMPLETED

1955

O.W.W.O.

7/27 5" @ 3272 DD 3287 S/5 BOPH
33% wtr.
L. 2966', A. 3268'
TD 3280'

8/10 ~~Comm 6/29/55~~

~~H 2852~~

~~Fr 2877~~

~~Dg 2885~~

~~Bl 2965~~

~~L 2981~~

~~M 3270~~

~~A 3285~~

TD 3286

8 5/8" @ 551 w/300

~~DST 3048-72 1 hr Rec 125' O & GCM~~

~~BHP 765 5 1/2" 3286 w/125 swb 2 go~~

~~no wtr 1 hr swb 1 1/2 bo no wtr 11 hrs~~

~~swb 2 bo no wtr 2 hrs 300 acid swb~~

~~1 1/2 bo plus 4 B acid wtr 15 hrs 500~~

~~acid no tst swb 1 1/2 bo in 7 hrs plus~~

~~tract wtr Ph. P. 98 bopd no wtr.~~

Error

8/10 L 2966, A 3268

TD 3280

5" @ 3272 DD 3287 S/5 boph 33%

wtr Comp 20 bopd 60 bw

COMPLETED

OWWO

County Rice Elev. 1758
 Sec. 18 Twp. 18 Rge. 10W
 Company Tom Allan & Holl
 FarmName Poppelreiter No. 1

TOPS	DEPTH	LOG	DATUM	Loc. in Sec.
Anh.				NE SE NE
Tr.				
H.				
Dg.				
Bl.				
L.	<u>2966</u>		<u>1208</u>	Geol.
N.C.				Contr.
B.K.C.				
Ce.				
C.				
M.				Pool
K.				<u>Roesler</u>
Mz.				
Ma.				
V.				
S.				
A.	<u>3268</u>		<u>1510</u>	<u>AUG 10 1955</u>
R.				COMPLETE
Pe.				
G.				
T.D.	<u>3280</u>			

Date Comm. 5" @ 3272 DD 3287 S/ 5 boph 33% wtr.
 Comp. 20 bopd 60 bw

OWWO

O.W.W.O.

County Rice Elev. 1758
 Sec. 18 Twp. 18 Rge. 10W
 Company Tom Allan & Holl
 FarmName Poppelreiter No. 1

TOPS	DEPTH	LOG	DATUM	Loc. in Sec.
Anh.				NE SE NE
Tr.				
H.				
Dg.				
Bl.				
L.	<u>2966</u>			Geol.
N.C.				Contr.
B.K.C.				
Ce.				
C.				
M.				Pool
K.				<u>Roesler</u>
Mz.				
Ma.				
V.				
S.				
A.	<u>3268</u>			FIRST REPORT
R.				
Pe.				<u>JUL 27 55</u>
G.				
T.D.	<u>3280</u>			

Date Comm. 5" @ 3272 DD 3287 S/ 5 boph 33% wtr.

12