

KANSAS

Rice

Sec. 18 Twp. 18 R. 10-WWell No. #1 Gemeinhardt FarmPrice et al

Company


330 Ft. from N. Line

Ft. from S. Line

330 Ft. from E. Line

Ft. from W. Line

Elev. 1765

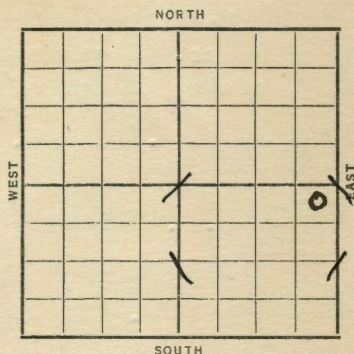

Date REPORT

1937

12/15 C. R.

12/24 15" @ 72'. 12" @ 275'.

Drlg. 410'.

12/31 Anhy 534'. 12" @ 537'.

Drlg. 550'.

1938

1/7 Drlg. 1500'.

1/14 10" @ 1665'. Fsg. bailer.

1/20 T.D. 2255' Drlg. up bit.

1/28 8" - 2299' Drlg. 2835'

2/2 Top Kansas City 2978'.

1700' water from 3180-85'.

5" set 3230'. Top Cong. 3276'.

T. Arb. 3297'. Oil Pay 3304-06


T.D. 3306'. 1000' oil in 6 hrs.

Shut down. (Tel)

OVER

Rice

KANSAS

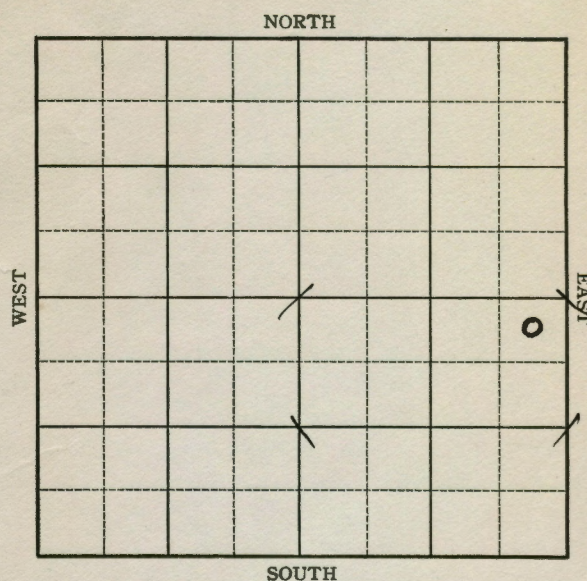Section 18 Township 18 Range 10-1Well No. 1 GemeinhardtCompany Price et al

1938

2/3--**Top Arbuckle 3297'**. T.D. 3306'.

Hole filled up 2800 feet oil in 30
hours. Clean out & were U. R. 5"
casing to top of arbuckle. (Tel)

2/11 **Cong. 3265'**. **Arb. 3286'**.

Oil Pay 3293-95'.

T.D. 3297' (Corrected)

700' oil 4 hrs. 1000' oil in
6 hrs. 5" @ 3290'. Drlg. plug.

2/18 900 & 1000 acid. Would only take
300 gal. Pumped about 5 bbls.
oil every 2 hrs. Will deepen.

2/24---T.D. 3304'. H.F.W. Will P.B. & Test
upper sands. (Tel)

2/26 T.D. 3304'. H.F.W.

Will plug back.

3/4 T.D. 3305'. P.B. 3298'. 2000 acid.

3/11 2 bbls. oil per hour 7 hrs.

S. D. O.

3/18 3000 acid.

3/25 " " Acid no help.

S. D. O.

4/1 " "

4/8 S.D.O.

4/15 "

4/20 5" @ 3290'.

Arb. 3286'.

T.D. 3305'.

COMPLETED
ABANDONED

ABANDONED

Rice

KANSAS

Map No. 53 Sec. 18 Twp. 18 R. 10WWell No. 1 GemeinhardtPrice etal

Company

Contractor

ABANDONED

NE SE

330 Ft. from N. Line

Ft. from S. Line

330 Ft. from E. Line

Ft. from W. Line

SECTION PLAT

			0

Location

Rig up

Drilling and Remarks:

RECORD

Cased 5 in., 3290 ft.Sand 4-6 3286

Gas

Oil

Total Depth 3305

PRODUCTION

1st 24 hrs. Nat.

1st 24 hrs. after shot

Gas Cu. Ft.

Dry Hole

Abandoned

Date

APR 20 1938

19

H. D. Hatfield Scout

Rice

KANSAS

Map No. 53 Sec. 18 Twp. 18 R. 10WWell No. 1 GemeinhardtPrice etal

Company

Contractor

FIRST REPORT

NE SE

330 Ft. from N. Line

Ft. from S. Line

330 Ft. from E. Line

Ft. from W. Line

SECTION PLAT

			0

Location

Rig up

Drilling and Remarks:

CR

RECORD

Cased in., ft.

Sand

Gas

Oil

Total Depth

PRODUCTION

1st 24 hrs. Nat.

1st 24 hrs. after shot

Gas Cu. Ft.

Dry Hole

Abandoned

Date

DEC 15 1937

19

H. D. Hatfield Scout