


KANSAS Rice

Section 18 Township 18 Range 10W

Well No. 1 Hertach

Company Skelly

Orth Pool
NORTH

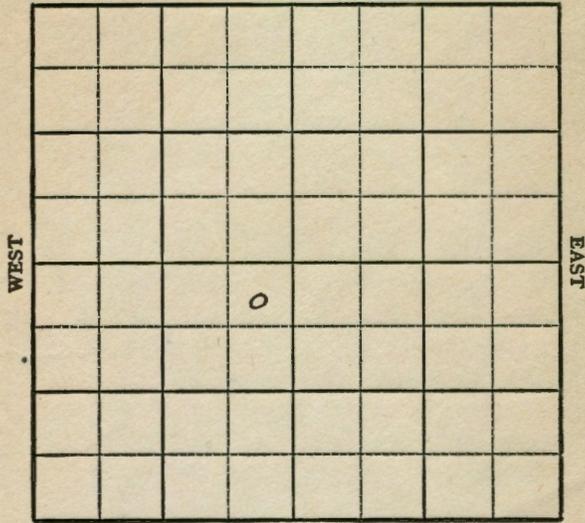

SOUTH

Rice

Sec. 18 Twp. 18 R. 10W ✓

Well No. #1 Hertach Farm

Skelly Company

Orth Pool


330' Ft. from N. Line

_____ Ft. from S. Line

330' Ft. from E. Line

_____ Ft. from W. Line

NE SW

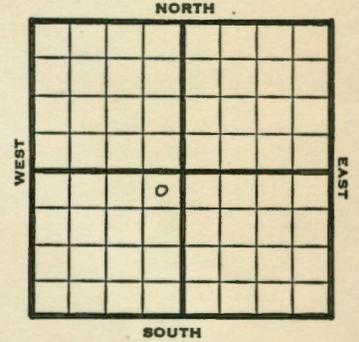

1948 **Elev. 1768'** REPORT

11/23 Location
 11/30 "
 12/8 8" @ 268'
 12/15 Drlg 3080'
 12/22 **Lans. 2998'**
Arb. 3307'
 TD 3332'

ABANDONED

Map No. 55 Sec. 18 Twp. 18 R. 10W

Well No. 1 Hertach

Skelly Company

ABANDONED Contractor

NE SW

E11768
SECTION PLAT


330 Ft. from N. Line

_____ Ft. from S. Line

330 Ft. from E. Line

_____ Ft. from W. Line

Rice County

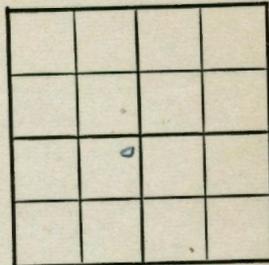

Location _____

Rig up _____

Drilling and Remarks:

Lane 2995

at 8307

RECORD

Cased _____ in., _____ ft.

Sand _____

Gas _____

Oil _____

Total Depth 2892

PRODUCTION

1st 24 hrs. Nat. _____

1st 24 hrs. after shot _____

Gas _____ Cu. Ft.

Dry Hole _____

Abandoned _____

Date

DEC 22 1948 19

S. J. LEWIS

Scout

Map No. _____ Sec. 18 Twp. 18 R. 10W

Well No. 1 Hertach

Skelly Company

FIRST REPORT

Contractor

NE SW

SECTION PLAT


330 Ft. from N. Line

_____ Ft. from S. Line

330 Ft. from E. Line

_____ Ft. from W. Line

Rice County

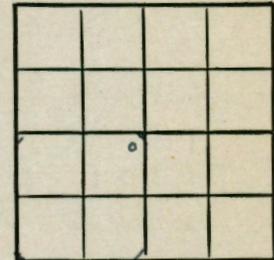

Location X

Rig up _____

Drilling and Remarks:

RECORD

Cased _____ in., _____ ft.

Sand _____

Gas _____

Oil _____

Total Depth _____

PRODUCTION

1st 24 hrs. Nat. _____

1st 24 hrs. after shot _____

Gas _____ Cu. Ft.

Dry Hole _____

Abandoned _____

Date

NOV 23 1948 19

S. J. LEWIS

Scout