


Section 18 Township 18 **KANSAS** Range 10W

Well No. #1 Hertach

Company Murfin Drlg.

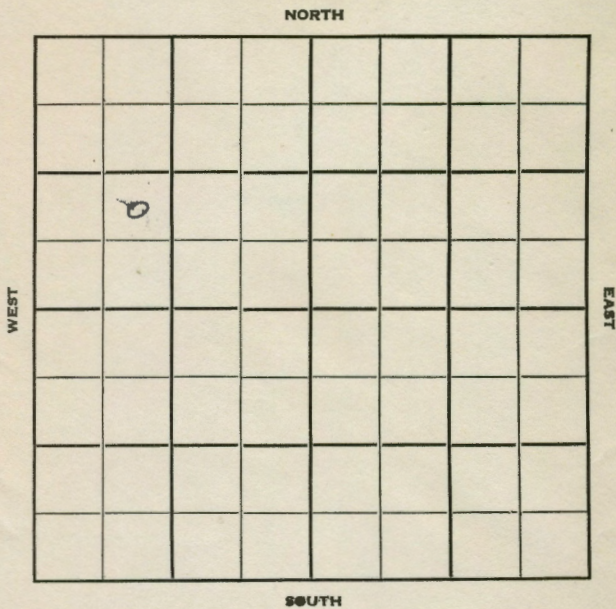

Rice **KANSAS**  
Sec. 18 Twp. 18 R. 10W

Well No. #1 Hertach Farm

Murfin Drlg. Company

Ash-Mur - Contr. Contractor

Wildcat


Ft. from N. Line

990' Ft. from S. Line

Ft. from E. Line

990' Ft. from W. Line

NE SW NW

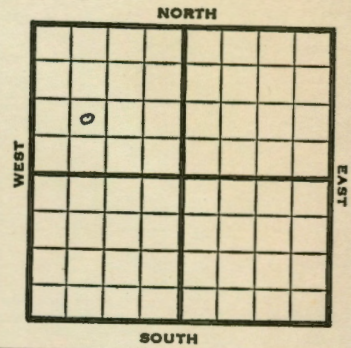

1951

**Elev. 1775'**

REPORT

5/16

Spud 5-5-51  
Br Line 2974  
Lans. 2987'  
Drlg. 3262'

6/13

Spud 5-5-51  
Oil well TD 3292'  
Br. line 2974' Lans 2987'  
Arb. 3283-87' 5" @ 3284' 1000 A  
2 BOPH DD 3292' 500 A  
S/2 BO 2 hr. 1000 A no inc.  
S/1 BOPH  
Comp. 25 BOPD

**COMPLETED**

