


Section 18 Township 18 Range 10W

Well No. #2 Hertach

Company Murfin Drlg.

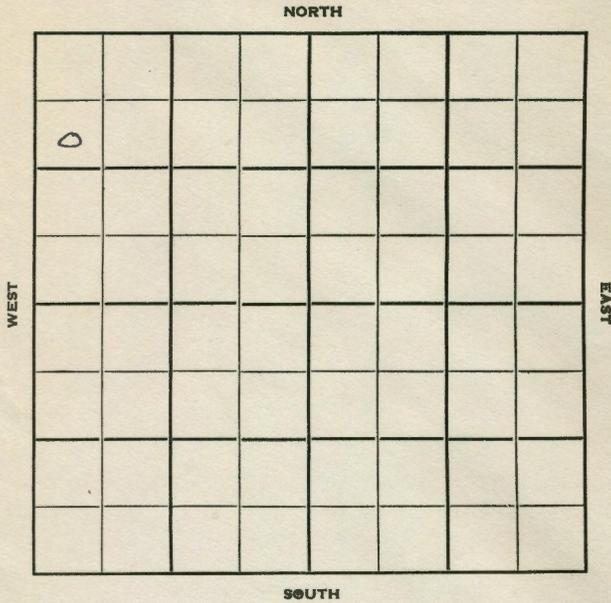

Sec. 18 Twp. 18 R. 10W

Well No. #2 Hertach Farm

Murfin Drlg. Company

Murfin Contractor


990 Ft. from N. Line

_____ Ft. from S. Line

_____ Ft. from E. Line

330 Ft. from W. Line

SW NW NW

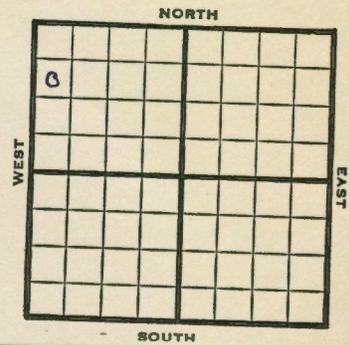

1952

Blev. 1774' REPORT

3/5 Location

3/11 8" @ 222
Drlg. 1750'

3/19 Heeb. 2859 Br Li 2772
Lans. 2988 Arb. 3284
RTD 3289 5" @ 3285'

3/25 NR

4/1 "

4/9 Spud 3-8-52
Oil well TD 3289' 8" @ 222
Heeb 2859' Br. li. 2972' Lans 2988
Arb. 3284' TD 3289' 5" @ 3285'
CO to 3289' FU 1600' oil 12 hr.
Comp. 25 BOPD

COMPLETED

