


Rice

KANSAS

Section 18 Township 18 Range 10W

Well No. #2 Marilyn Zink

Company Skelly Oil

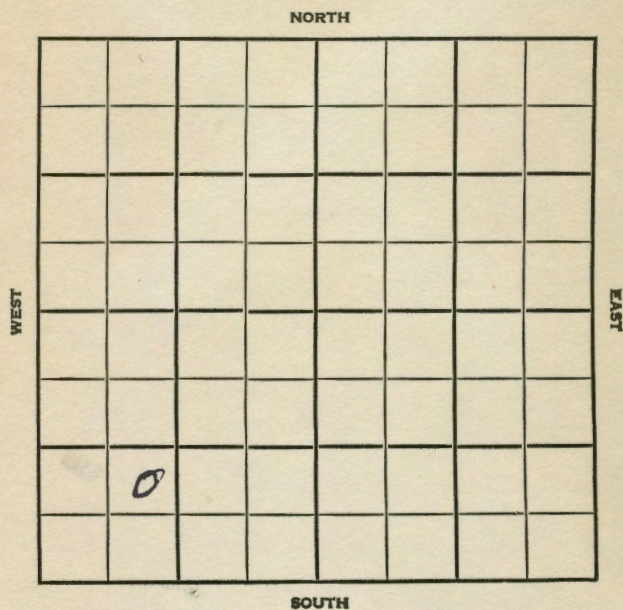

SEC.		TWP.		R.	
18		18		10 W	
WELL NO.					
# 2 Marilyn Zink					
FARM					
COMPANY					
Skelly Oil					
CONTRACTOR					


Zink

Ft. from N. Line

Ft. from S. Line

Ft. from E. Line

_____ Ft. from W. Line

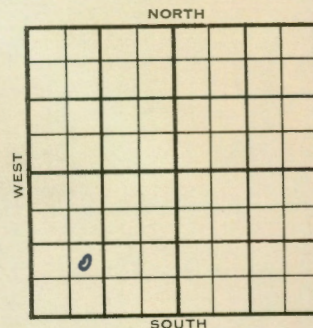

NE SW SW

1955	ELEVATION 1772'	REPORT
6/8	Comm. 5-7-55 8-5/8" @ 554/300 DST 3059-71 open 1 hr rec 115' oil 60' MCO, 120' HOCM. DST 3076-95 open 1 hr rec 70' MSW 815# DST 3259-71 open 1 hr rec 5' mud. 38# 5½" @ 3283/125-1511 DD 3291 S/3¼ BO 11 hr. 500 A S/56 BO 7 hr. P/66 BO 5 hr. Comp. 302 BOPD Anhy 544', H. 2849', Sd 2880', BL. 2962', L. 2979' C. 3265', A. 3281', TD 3284'	FIRST REPORT COMPLETED

DX-78

DX-78

County	Rice	Elev.	1772	Co.
Sec.	18	Twp.	18	
		Rge.	LOW	
Company	Skelly Oil			
Farm Name	Marilyn Zink			No. 2

TOPS	DEPTH	LOG	DATUM	Loc. in Sec.
Anh.	544			NE SW SW
Tr.	2849		1077	
H.				
Tr.				
Dg. sd	2880		1108	
Bl.	2962		1190	
L.	2979		1207	Geol.
K.C.				Cantr.
B.K.C.				
Ce.				
C.	3265		1493	
M.				Pool
M.				Zink
K.				
Mz.				
Ma.				
V.				
S.				
S.				
A.	3281		1509	
R.				
PE.				
G.				
T.D.	3284		1512	

Date Comm.	5-7-55	JUN 8 1955	Sec.
8 5/8" @ 554/300	DST 3059-71	open 1 hr	
Rec. 115' oil	60' mco	120' hocm	
DST 3076-95	open 1 hr.	Rec. 70' msw	
815#	DST 3259-71	open 1 hr.	T.
5' mud	38# 5 1/2" @ 3283/	125-1511	
DD 3291	S/ 34 bo	11 hr. 500 A	
S/ 56 bo	7 hr.	P/ 66 bo 5 hr.	
Comp. 302 bopd			R.